

PEARL RIVER
 V 84
 9-9-72

MISSISSIPPI
 BOARD OF WATER COMMISSIONERS
 416 North State Street
 Jackson, Mississippi 39201

CODED

WATER WELL DRILLERS LOG

9/9 1972 *Red Forest Dr* *Pearl River*
 date well completed firm name county well located

LANDOWNER: *Don Gordon*
R.3 Highway Miss.
 (mailing address)

description of formations encountered		from	to
<i>Red shale</i>		<i>0</i>	<i>30</i>
<i>Blue shale</i>		<i>30</i>	<i>175</i>
<i>white sand</i>		<i>175</i>	<i>210</i>
<i>Blue shale</i>		<i>210</i>	<i>560</i>
<i>Blue sand</i>		<i>560</i>	<i>588</i>

WELL LOCATION:
 sec. *20* T *5* N R *16* E
2 miles *N* of *Osage*
 (distance) (direction) (nearest town)

WELL PURPOSE: *hand*
 (home, irrigation, municipal, industrial)

WELL COMPLETION DATA:

(1) diameter (inches) *2 1/4*

(2) total depth (feet) *588*

(3) static water level (feet) *33* below above top of ground.

(4) casing *galv 5'* (material) (depth)
2 1/4" (size) if telescope see back.

(5) screen *2x10 5-78* (length) (depth to top)
2x10 galv (size) (material)

(6) pump (HP) (yield gpm)
electric (type power)

(7) electric log *NO* (yes or no)
 (organization running log)

(8) how well bottom plugged *hand*

CODED


DRILLERS REMARKS:
no pump furnished

SEP 11 1972

MISS. Bd.
 WATER

If well telescopes please sketch and show depths.

GROUND LEVEL

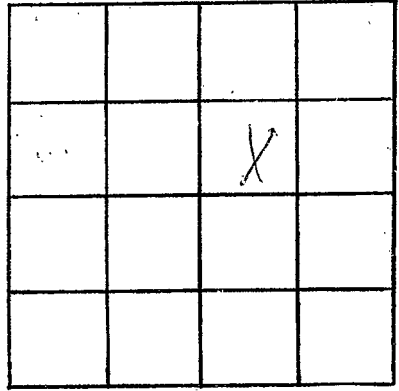

SECTION _____

Please indicate well location X.

ADDITIONAL INFORMATION

If more than one screen,
show locations of each on sketch.