

PEARL RIVER  
 V 86  
 2-15-73

MISSISSIPPI  
 BOARD OF WATER COMMISSIONERS  
 416 North State Street  
 Jackson, Mississippi 39201

CODED

WATER WELL DRILLERS LOG

2-15-73 date well completed  
 1973 Penton Well Sord firm name  
 Pearl River county well located

LANDOWNER: Harry Stockstill  
 Pt. 2  
 Piquette, Miss  
 (mailing address)

description of formations encountered	from to	
Surface Clay	0	18
Red Sand	18	38
White Clay	38	55
Blue Clay	55	162
Fine Sand	162	180
Blue Clay	180	440
Sand	440	478

WELL LOCATION:  
 sec. 34 T. 5 S. R. 16 W.  
 5 miles N.E. of Piquette  
 (distance) (direction) (nearest town)

WELL PURPOSE: HOME  
 (home, irrigation, municipal, industrial)

WELL COMPLETION DATA:


(1) diameter (inches) 2  
 (2) total depth (feet) 478  
 (3) static water level (feet) 28 below top of ground.  
 (4) casing Galv. 468 (material), (depth)  
 2 (size) if telescope see back.  
 (5) screen 10' 468 (length), (depth to top)  
 2, S. Steel (size), (material)  
 (6) pump 1/2 8 (HP), (yield gpm)  
 Elec (type power)  
 (7) electric log NO (yes or no)  
 (organization running log)  
 (8) how well bottom plugged B.W. Valve

CODED

DRILLERS REMARKS:

If well telescopes please sketch and show depths.

GROUND LEVEL

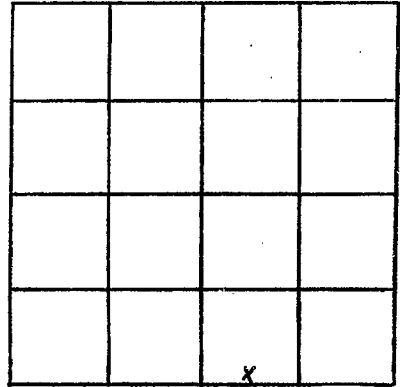

SECTION 34

Please indicate well location X.

ADDITIONAL INFORMATION

If more than one screen,  
show locations of each on sketch.