

PEARL RIVER
 V 88
 3-19-73

MISSISSIPPI
 BOARD OF WATER COMMISSIONERS
 416 North State Street
 Jackson, Mississippi 39201

CODED

WATER WELL DRILLERS LOG

3/19 1973 Bud Benton & Son Pearl River
 date well completed firm name county well located

LANDOWNER: Joyce
 Mc Boney
 A. T. 1 P. Proyer
 (mailing address)

description of formations encountered	from	to
white shale	0	36
white sand	36	40
blue shale	40	570
blue sand	570	570

WELL LOCATION:
 sec. 29 T 5 N R 16 E
 3 miles E of McComb
 (distance) (direction) (nearest town)

WELL PURPOSE: none
 (home, irrigation, municipal, industrial)

WELL COMPLETION DATA:
 (1) diameter (inches) 2"
 (2) total depth (feet) 570
 (3) static water level (feet) 2 pd - below top of ground.
 (4) casing 560, 4.6
 (material) (depth)
 (size) if telescope see back.
 (5) screen 2x18 560
 (length) (depth to top)
 2x5 Stainless Steel
 (size) (material)
 (6) pump no
 (HP) (yield gpm)
 (type power)
 (7) electric log no
 (yes or no)
 (organization running log)
 (8) how well bottom plugged sand
 shale


CODED

APR 20 1973

DRILLERS REMARKS:

If well telescopes please sketch and show depths.

GROUND LEVEL

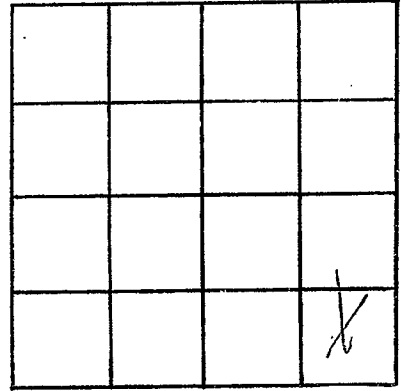

SECTION _____

Please indicate well location X.

ADDITIONAL INFORMATION

If more than one screen, show locations of each on sketch.