

Pearl River
V91
4-21-73

MISSISSIPPI
 BOARD OF WATER COMMISSIONERS
 416 North State Street
 Jackson, Mississippi 39201

CODED

WATER WELL DRILLERS LOG

4/21/73 date well completed Sumplin Well Serv. firm name Pearl River county well located

LANDOWNER: Bob Nicholson

description of formations encountered

from to

A. 2

Carriere, Miss.
 (mailing address)

Clay

0 15

Sand

15 75

WELL LOCATION:

sec. 26 T N R 16 E
6 miles E of Carriere
 (distance) (direction) (nearest town)

Clay

75 375

Sand

375 447

WELL PURPOSE: home
 (home, irrigation, municipal, industrial)

WELL COMPLETION DATA:

- (1) diameter (inches) 2"
- (2) total depth (feet) 447
- (3) static water level (feet) 90 -below above top of ground.
- (4) casing Gal. 449
 (material) (depth)

_____ if telescope see back.
 (size)

- (5) screen 5' 442
 (length) (depth to top)

2' 5' Steel
 (size) (material)

- (6) pump 1/2 Gal 280 gal.
 (HP) (yield gpm)

Edco
 (type power)

- (7) electric log NO
 (yes or no)

_____ (organization running log)

- (8) how well bottom plugged B. A. V


DRILLERS REMARKS:

MAY 24 1973

CODED

If well telescopes please sketch and show depths.

GROUND LEVEL

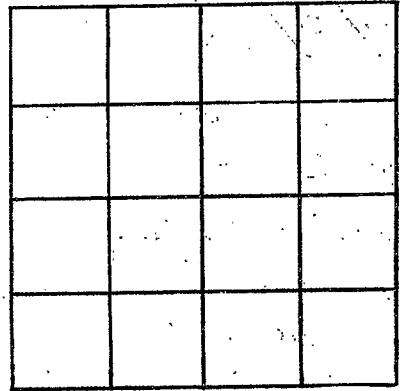

SECTION _____

Please indicate well location X.

ADDITIONAL INFORMATION

If more than one screen, show locations of each on sketch.