

V93  
PEARL RIVER  
6-29-73

MISSISSIPPI  
BOARD OF WATER COMMISSIONERS  
416 North State Street  
Jackson, Mississippi 39201

CODED

WATER WELL DRILLERS LOG

6/29 1973 Bud Denton Pearl River  
date well completed firm name county well located

LANDOWNER: A.A. DEAN

PICAYUNE MISS.

description of formations encountered	from	to
white shale	0	31
white sand	31	96
Blue shale	96	210
Blue sand	210	275
Blue shale	275	560
Gray sand	560	730
Blue shale	730	960
Blue sand	960	1100

(mailing address)

WELL LOCATION:

sec. 29 T 5 N R 16 E  
2 miles E of Picayune  
(distance) (direction) (nearest town)

WELL PURPOSE: home  
(home, irrigation, municipal, industrial)

WELL COMPLETION DATA:


- (1) diameter (inches) 2"
- (2) total depth (feet) 1100
- (3) static water level (feet) 14 ft below top of ground.
- (4) casing galv. 1100 (material) (depth)
- (5) screen 2x30, 1070 (length) (depth to top)  
12 (size) galv. (material)
- (6) pump 70 (HP) 3800 (yield gpm)
- (7) electric log \_\_\_\_\_ (yes or no)
- (8) how well bottom plugged \_\_\_\_\_

DRILLERS REMARKS:

AUG 19 1973

If well telescopes please sketch and show depths.

GROUND LEVEL

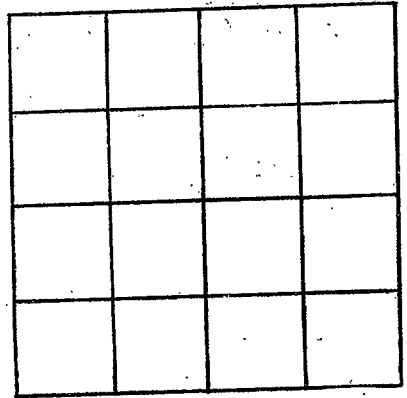

SECTION \_\_\_\_\_

Please indicate well location X.

ADDITIONAL INFORMATION

If more than one screen,  
show locations of each on sketch.