

P.R.
V95
10-5-73

MISSISSIPPI
BOARD OF WATER COMMISSIONERS CODED
416 North State Street
Jackson, Mississippi 39201

WATER WELL DRILLERS LOG

10-5 date well completed
1973 firm name
County well located

Samuel H. ...
Samuel H. Well Serv.
Paul ...

LANDOWNER: *Mr. N. ...*
Onchan Lake
Cassius, Miss
(mailing address)

description of formations encountered	from	to
<i>Clay</i>	<i>10</i>	<i>95</i>
<i>Sand</i>	<i>95</i>	<i>135</i>
<i>Clay</i>	<i>135</i>	<i>180</i>
<i>Sand</i>	<i>180</i>	<i>212</i>

WELL LOCATION:
sec. 9 T. N R. 16 E
50 S 16 W
2.5 miles E of Cassius
(distance) (direction) (nearest town)

WELL PURPOSE: *Home*
(home, irrigation, municipal, industrial)

- WELL COMPLETION DATA:
- (1) diameter (inches) 2"
 - (2) total depth (feet) 207
 - (3) static water level (feet) 30 below top of ground.
 - (4) casing P.V.C., 207,
(material) (depth)
2"
(size) if telescope see back.
 - (5) screen 5', 207
(length) (depth to top)
2", P.V.C.
(size) (material)
 - (6) pump 1/2, 300 P.H.
(HP) (yield gpm)
Elec.
(type power)
 - (7) electric log No
(yes or no)
- (organization running log)
- (8) how well bottom plugged Samuel H. ...


CODED

OCT 26 1973

DRILLERS REMARKS:

If well telescopes please
sketch and show depths.

GROUND LEVEL

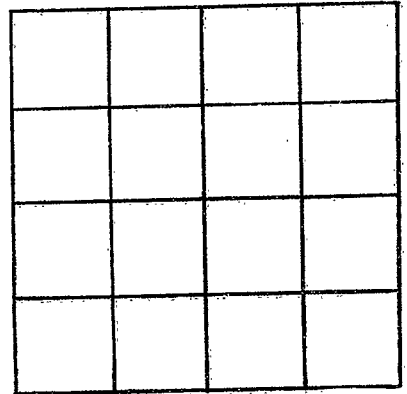

SECTION _____

Please indicate well location X.

ADDITIONAL INFORMATION

If more than one screen,
show locations of each on sketch.