

Pearl River
 V102
 6-13-74

MISSISSIPPI
 BOARD OF WATER COMMISSIONERS
 416 North State Street
 Jackson, Mississippi 39201

CODED

WATER WELL DRILLERS LOG

6-13 date well completed 1974 Pumpkin Well Dr. firm name Pearl River county well located

LANDOWNER: Southland Development
Carriere, Miss.
 (mailing address)


description of formations encountered	from	to
	Clay	0
Sand	95	130
Clay	130	190
Sand	190	246

WELL LOCATION:
 sec. 9 T. 5 N. R. 16 E.
2.5 miles East of Carriere
 (distance) (direction) (nearest town)

WELL PURPOSE: Home
 (home, irrigation, municipal, industrial)

- WELL COMPLETION DATA:
- (1) diameter (inches) 2"
 - (2) total depth (feet) 246'
 - (3) static water level (feet) 25 below above top of ground.
 - (4) casing P.V.C., 240
 (material) (depth)
2" if telescope see back.
 (size)
 - (5) screen 6, 240'
 (length) (depth to top)
2", P.V.C.
 (size) (material)
 - (6) pump 1/2, 700 h.k.
 (HP) (yield gpm)
Elec.
 (type power)
 - (7) electric log. no
 (yes or no)
No
 (organization running log)
 - (8) how well bottom plugged Final Seal

CODED

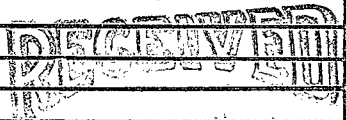


AUG - 8 1974

DRILLERS REMARKS:

If well telescopes please sketch and show depths.

GROUND LEVEL

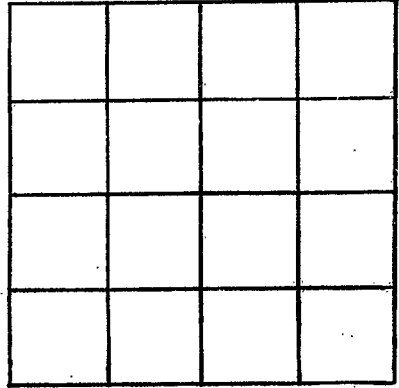

SECTION _____

Please indicate well location X.

ADDITIONAL INFORMATION

If more than one screen, show locations of each on sketch.