

P.R.
 V 103
 12-18-73

MISSISSIPPI
 BOARD OF WATER COMMISSIONERS
 416 North State Street
 Jackson, Mississippi 39201

CODED

WATER WELL DRILLERS LOG

12-18 1973 Bud Luter & Son Lead Run
 date well completed firm name county well located

LANDOWNER:

Anthony Hill
 Ocean Springs, Miss.
 (mailing address)

description of formations encountered

	from	to
white shale	0	12
white sand	12	30
gray shale	30	60
red sand	60	105
blue shale	105	510
gray sand	510	600
blue shale	600	710
gray sand	710	815
blue shale	815	911
gray sand & rock	911	948

WELL LOCATION:

sec. 29 T 5 N R 16 E
 3 miles E of Ric.
 (distance) (direction) (nearest town)

WELL PURPOSE: Home
 (home, irrigation, municipal, industrial)

WELL COMPLETION DATA:

- (1) diameter (inches) 2 1/2
- (2) total depth (feet) 948
- (3) static water level (feet) 13 1/2 below top of ground.
- (4) casing Galv. 923
 (material) (depth)

(size) if telescope see back.

- (5) screen 2x25 923
 (length) (depth to top)
2x25 S.S. No. 15
 (size) (material)


- (6) pump _____ (HP) _____ (yield gpm)
flow
 (type power)

- (7) electric log no
 (yes or no)

(organization running log)

- (8) how well bottom plugged
Sand Shank

CODED

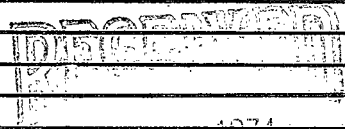

JAN 7 1974

DRILLERS REMARKS:

