

P.R.

V104

9-26-73

MISSISSIPPI BOARD OF WATER COMMISSIONERS **CODED**
 416 North State Street
 Jackson, Mississippi 39201

WATER WELL DRILLERS LOG

9-26

1973

Bud Lentz & Son

Leard River

date well completed

firm name

county well located

LANDOWNER:

Wayne Hill
Peachtree, Miss.

description of formations encountered

from to

white shale	0	12
white sand	12	75
blue shale	75	240
blue sand	240	360
blue shale	360	520
gray sand	520	766
blue shale	766	960
gray sand	960	1073

(mailing address)

WELL LOCATION:

sec 29 T 5 N R 16 E
 3 miles E of Riv.
 (distance) (direction) (nearest town)

WELL PURPOSE:

Home (home, irrigation, municipal, industrial)

WELL COMPLETION DATA:

CODED

- (1) diameter (inches) 2 in
- (2) total depth (feet) 1073
- (3) static water level (feet) 14 1/2 below top of ground.
- (4) casing Galv. (material), 1048 (depth)
- _____ if telescope see back. (size)
- (5) screen 2x25, 1048 (length), (depth to top)
2 in, S.S. No. 12 (size), (material)
- (6) pump _____ (HP) _____ (yield gpm)
None (type power)
- (7) electric log no (yes or no)
- _____ (organization running log)


(8) how well bottom plugged
Sand Shale

DRILLERS REMARKS:

JAN 7 1974

If well telescopes please sketch and show depths.

GROUND LEVEL

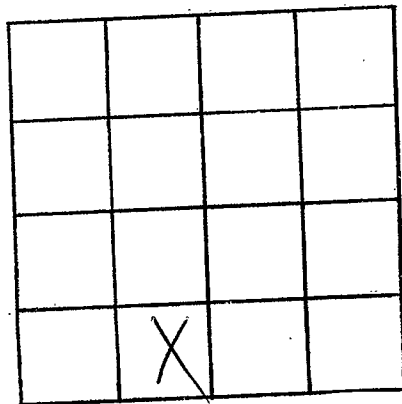

SECTION _____

Please indicate well location X.

ADDITIONAL INFORMATION

If more than one screen,
show locations of each on sketch.