

P.R.
V105
1-9-74

MISSISSIPPI
BOARD OF WATER COMMISSIONERS
416 North State Street
Jackson, Mississippi 39201

CODED

WATER WELL DRILLERS LOG

1-9-74 19 date well completed
 Sumptin Well Service, Paul Hines firm name
 county well located

LANDOWNER: Anchor Lake
 Subdivision
 Carriere, Miss
 (mailing address)

description of formations encountered	from	to
Clay	0	180
Sand	180	215

WELL LOCATION:
 sec. 7 T 5 N R 16 E
 2 1/2 miles S of Carriere
 (distance) (direction) (nearest town)

WELL PURPOSE: home
 (home, irrigation, municipal, industrial)

- WELL COMPLETION DATA:
- (1) diameter (inches) 2"
 - (2) total depth (feet) 215
 - (3) static water level (feet) 40 below top of ground.
 - (4) casing P.V.C. 210 (material), (depth)
 2" (size) if telescope see back.
 - (5) screen 5 (length), 210 (depth to top)
 2" (size), P.V.C. (material)
 - (6) pump 1/2 (HP), 700 gpm (yield gpm)
 Che. (type power) 11 gpm
 - (7) electric log no. (yes or no)

CODED

(organization running log)
 (8) how well bottom plugged Sand Seal


DEPT. OF REVENUE
 JAN 17 1974

DRILLERS REMARKS:

MISS. BD. OF WATER COMMISSIONERS

If well telescopes please sketch and show depths.

GROUND LEVEL

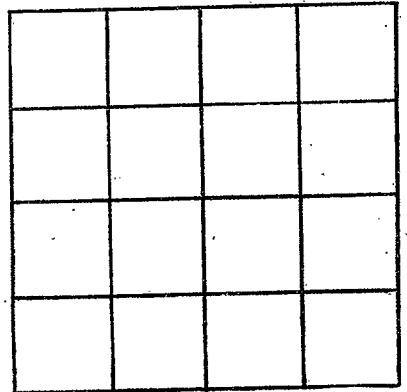

SECTION _____

Please indicate well location X.

ADDITIONAL INFORMATION

If more than one screen, show locations of each on sketch.