

PEARL R.
V 107
Lot. # 27
4-5-74

MISSISSIPPI
 BOARD OF WATER COMMISSIONERS **CODED**
 416 North State Street
 Jackson, Mississippi 39201

WATER WELL DRILLERS LOG

April 5 1974 Lumpkin Well Dr. Pearl River
 date well completed firm name county well located

LANDOWNER: Anchor Lake
Subdivision
Camrose, Miss.
 (mailing address)

description of formations encountered	from	to
<u>Clay</u>	<u>0</u>	<u>80</u>
<u>fine sand</u>	<u>10</u>	<u>100</u>
<u>Clay</u>	<u>100</u>	<u>240</u>
<u>level sand</u>	<u>340</u>	<u>365</u>

WELL LOCATION:
 sec. 9 T. 5 N. R. 19 E
2 1/2 miles East of Camrose
 (distance) (direction) (nearest town)

WELL PURPOSE: Home
 (home, irrigation, municipal, industrial)

- WELL COMPLETION DATA:
- (1) diameter (inches) 2"
 - (2) total depth (feet) 365
 - (3) static water level (feet) 40' below above top of ground.
 - (4) casing P.V.C. 360'
 (material) (depth)
2"
 (size) if telescope see back.
 - (5) screen 5' 365'
 (length) (depth to top)
2" P.V.C.
 (size) (material)
 - (6) pump 1/2 500
 (HP) (yield gpm/hr.)
Elec.
 (type power)
 - (7) electric log No
 (yes or no)
- (organization running log)
- (8) how well bottom plugged Small Shells


CODED

DRILLERS REMARKS:

APR 12 1974
MISS. Bd. OF WATER COM'RS

If well telescopes please sketch and show depths.

GROUND LEVEL

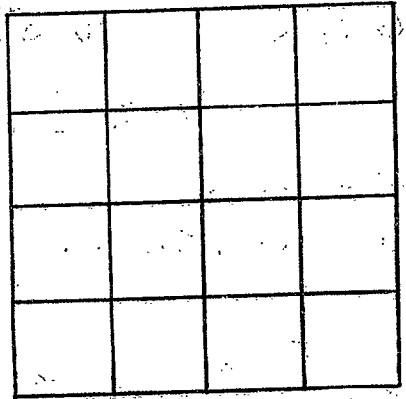

SECTION _____

Please indicate well location X.

ADDITIONAL INFORMATION

If more than one screen, show locations of each on sketch.