

Pearl River  
V 108  
1-25-74

MISSISSIPPI  
 BOARD OF WATER COMMISSIONERS  
 416 North State Street  
 Jackson, Mississippi 39201

CODED

WATER WELL DRILLERS LOG

*Pearl River*

1-25-74  
 date well completed

Earl Penton Water Well Serv.  
 firm name

county well located

LANDOWNER:  
Mr. Huey Taylor  
Carriere Miss.  
 (mailing address)

| description of formations encountered | from       | to         |
|---------------------------------------|------------|------------|
| <u>Red clay</u>                       | <u>0</u>   | <u>17</u>  |
| <u>Co. white sd. &amp; Gv.</u>        | <u>17</u>  | <u>78</u>  |
| <u>white clay</u>                     | <u>78</u>  | <u>96</u>  |
| <u>Blue clay</u>                      | <u>96</u>  | <u>240</u> |
| <u>Co. Blue sd. &amp; Gv.</u>         | <u>240</u> | <u>267</u> |

WELL LOCATION:  
 sec 13 T 5 N R 16 E  
5 miles E of Carriere  
 (distance) (direction) (nearest town)

WELL PURPOSE: Home  
 (home, irrigation, municipal, industrial)

WELL COMPLETION DATA:

(1) diameter (inches) 4 1/2

(2) total depth (feet) 267

(3) static water level (feet) 57 below above top of ground.

(4) casing Cole 267  
 (material) (depth)

2" If telescope see back.  
 (size)

(5) screen 5' 262  
 (length) (depth to top)

2" 5.5  
 (size) (material)

(6) pump 1 3.50 hp.  
 (HP) (yield gpm)


Elect  
 (type power)

(7) electric log NO.  
 (yes or no)

(organization running log)

(8) how well bottom plugged shoe

CODED

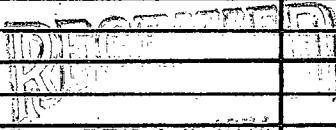


APR 19 1974

DRILLERS REMARKS:

If well telescopes please sketch and show depths.

GROUND LEVEL

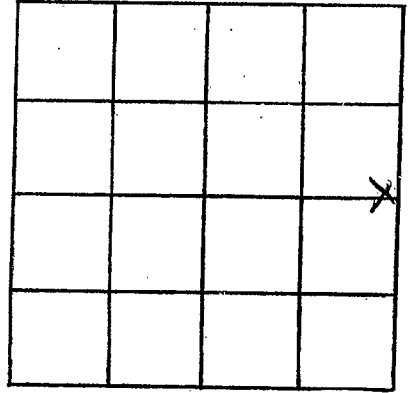

SECTION 13

Please indicate well location X.

ADDITIONAL INFORMATION

If more than one screen, show locations of each on sketch.