

MISSISSIPPI
BOARD OF WATER COMMISSIONERS
416 North State Street
Jackson, Mississippi 39201

CODED

WATER WELL DRILLERS LOG

P. R.
V109
4-16-74

4-16 date well completed 1974 Lumbkin Well Sec. firm name Paul Reiner county well located

LANDOWNER: Southland Dev. Corp.
Carriere, Miss.
(mailing address)

description of formations encountered	depth	
	from	to
Clay	0	90
Sand	90	110
Clay	110	230
Sand	230	265


WELL LOCATION:
sec. 7 T. 5 N. R. 16 E.
2 1/2 miles East Carriere
(distance) (direction) (nearest town)

WELL PURPOSE: None - (comb)
(home, irrigation, municipal, industrial)

- WELL COMPLETION DATA:
- diameter (inches) 2"
 - total depth (feet) 265
 - static water level (feet) 30 below top of ground.
 - casing P.V.C. 260
(material) (depth)
2" (size) if telescope see back.
 - screen 5' 260'
(length) (depth to top)
2" P.V.C.
(size) (material)
 - pump 1/2 600 G.P.M.
(HP) (yield gpm)
Elec.
(type power)
 - electric log NO.
(yes or no)
 - (organization running log)
 - how well bottom plugged Sand


CODED

DRILLERS REMARKS:

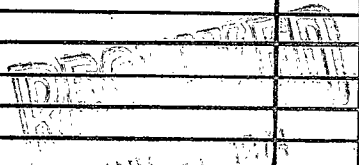

If well telescopes please sketch and show depths.

GROUND LEVEL

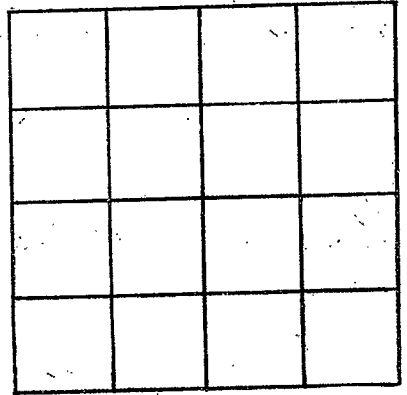

SECTION _____

Please indicate well location X.

ADDITIONAL INFORMATION

If more than one screen, show locations of each on sketch.