

Pearl R.  
 V 110  
 7/3/74

MISSISSIPPI  
 BOARD OF WATER COMMISSIONERS  
 416 North State Street  
 Jackson, Mississippi 39201 **CODED**

WATER WELL DRILLERS LOG

7-3 1974 Sumpter Well Serv P.R.  
 date well completed firm name county well located

LANDOWNER:	description of formations encountered	from	to
<u>Southland Development Inc</u> <u>Carriere, Miss.</u> (mailing address)	<u>Clay</u> <u>Sand</u> <u>Clay</u> <u>Sand</u>	<u>0</u> <u>20</u> <u>60</u> <u>150</u>	<u>30</u> <u>60</u> <u>150</u> <u>215</u>
<b>WELL LOCATION:</b>			
sec <u>8</u> T <u>5</u> N R <u>16</u> E <u>3</u> miles <u>West</u> of <u>Carriere</u> (distance) (direction) (nearest town)			
<b>WELL PURPOSE:</b> <u>None</u> (home, irrigation, municipal, industrial)			
<b>WELL COMPLETION DATA:</b>			
(1) diameter (inches) <u>2"</u>			
(2) total depth (feet) <u>215</u>			
(3) static water level (feet) <u>25</u> below above top of ground.			
(4) casing <u>P.V.C.</u> , <u>210</u> , (material) (depth) <u>2"</u> (size) if telescope see back.			
(5) screen <u>5'</u> , <u>215</u> (length) (depth to top)			
(6) pump <u>1/2</u> , <u>P.V.C.</u> (HP) (material) <u>550 P.H.</u> (yield gpm)			
<u>Elec.</u> (type power)			
(7) electric log <u>No</u> (yes or no)			
(organization running log)			
(8) how well bottom plugged <u>Sand Shrub</u>			
<b>DRILLERS REMARKS:</b>			


**CODED**

DEC 9 1974

MISS. Bd. OF WATER COMMISSIONERS

If well telescopes please sketch and show depths.

GROUND LEVEL

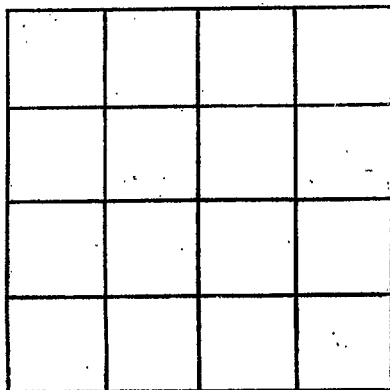

SECTION \_\_\_\_\_

Please indicate well location X.

ADDITIONAL INFORMATION

If more than one screen,  
show locations of each on sketch.