

P.R.
 V/III
 8/8/79

CODED

MISSISSIPPI
 BOARD OF WATER COMMISSIONERS
 416 North State Street
 Jackson, Mississippi 39201

WATER WELL DRILLERS LOG

8-8-1974 date well completed
 Lumberton Well Dr. firm name
 Pearl River county well located

LANDOWNER:	description of formations encountered	from	to
Southland Development Co. Carrier, Miss (mailing address)			
WELL LOCATION:			
sec 8 T 5 N R 7 E 3 miles W of Carrier (distance) (direction) (nearest town)			
WELL PURPOSE: Home (home, irrigation, municipal, industrial)			
WELL COMPLETION DATA:			
(1) diameter (inches) 2"			
(2) total depth (feet) 210			
(3) static water level (feet) 25 below top of ground.			
(4) casing P.V.C. 205 (material) (depth) 2" (size) if telescope see back.			
(5) screen 5 205 (length) (depth to top) 2" P.V.C. (size) (material)			
(6) pump 1/2 550 (HP) (yield gpm) Elec. (type power)			
(7) electric log No (yes or no)			
(8) how well bottom plugged Sand (organization running log)			
DRILLERS REMARKS:			


CODED

RECEIVED

OCT - 9 1974

If well telescopes please sketch and show depths.

GROUND LEVEL

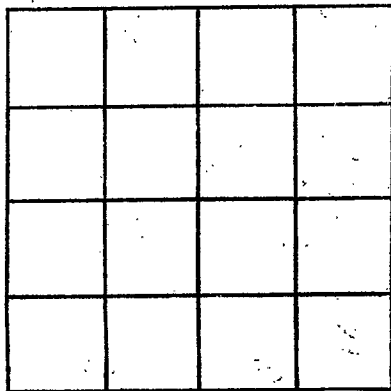

SECTION _____

Please indicate well location X.

ADDITIONAL INFORMATION

If more than one screen, show locations of each on sketch.