

P.R.  
 V112  
 6/29/74

MISSISSIPPI  
 BOARD OF WATER COMMISSIONERS  
 416 North State Street  
 Jackson, Mississippi 39201

CODED

WATER WELL DRILLERS LOG

6-29 date well completed  
 1974 Bud Lenton & Son firm name  
 Pearl River county well located

LANDOWNER:  
 Kuller Cont. Co.  
 Oceanic, Miss.  
 (mailing address)

WELL LOCATION:  
 sec 29 T 5 N R 16 E  
 3 miles E of Oceanic  
 (distance) (direction) (nearest town)

WELL PURPOSE: Home  
 (home, irrigation, municipal, industrial)

WELL COMPLETION DATA:

(1) diameter (inches) 2 in  
 (2) total depth (feet) 965  
 (3) static water level (feet) 84 below top of ground.  
 (4) casing 4 in. 945 (material) (depth)  
 (size) if telescope see back.  
 (5) screen 2x20 945 (length) (depth to top)  
 2x20 1. Steel 10012 (size) (material)  
 (6) pump (HP) (yield gpm)  
 flo (type power)  
 (7) electric log NO (yes or no)  
 (organization running log)  
 (8) how well bottom plugged sand shank

description of formations encountered	from	to
white shale	0	15
white sand	15	36
grey shale	36	72
red sand	72	108
blue shale	108	510
grey sand	510	615
blue shale	615	710
grey shale	710	825
blue shale	825	918
grey sand & rock	918	965


CODED

RECEIVED  
 OCT - 9 1974

DRILLERS REMARKS:

If well telescopes please sketch and show depths.

GROUND LEVEL

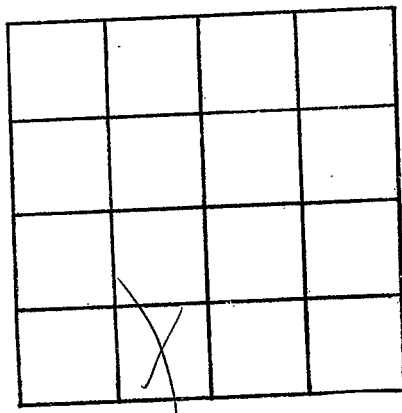

SECTION \_\_\_\_\_

Please indicate well location X.

ADDITIONAL INFORMATION

If more than one screen, show locations of each on sketch.