

P.R.
V 113
10-26-74

MISSISSIPPI
BOARD OF WATER COMMISSIONERS
416 North State Street
Jackson, Mississippi 39201

CODED

WATER WELL DRILLERS LOG

10-26
date well completed

24 *Lumpkin Well Co.*
firm name

Paul River
county well located

LANDOWNER:
Mr. James D. Masteller
1427 Seminary Place
New Orleans, La.
(mailing address)

description of formations encountered	from	to
<i>Clay</i>	<i>0</i>	<i>45</i>
<i>Sand</i>	<i>45</i>	<i>80</i>
<i>Clay</i>	<i>80</i>	<i>310</i>
<i>Sand</i>	<i>310</i>	<i>362</i>

WELL LOCATION:
sec. *8* T. *5* N. R. *14* E.
3 miles *West* of *Carriere*
(distance) (direction) (nearest town)

WELL PURPOSE: *None*
(home, irrigation, municipal, industrial)

- WELL COMPLETION DATA:
- (1) diameter (inches) *2"*
 - (2) total depth (feet) *362'*
 - (3) static water level (feet) *40'* below above top of ground.
 - (4) casing *P.V.C.*, *350'*
(material) (depth)
2"
(size) if telescope see back.
 - (5) screen *6'*, *357'*
(length) (depth to top)
2", *P.V.C.*
(size) (material)
 - (6) pump *1/2*, *550 gpm*
(HP) (yield gpm)
Elec.
(type power)
 - (7) electric log *No*
(yes or no)
 - (organization running log)
 - (8) how well bottom plugged *Level about*


CODED

DRILLERS REMARKS:

REGISTERED
DEC 6 1974

If well telescopes, please sketch and show depths.

GROUND LEVEL

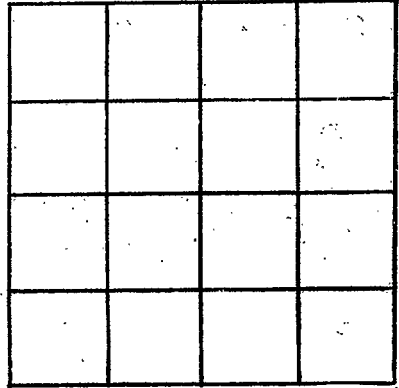

SECTION _____

Please indicate well location X.

ADDITIONAL INFORMATION

If more than one screen,
show locations of each on sketch.