

P.R.
 V114
 10-31-74

MISSISSIPPI
 BOARD OF WATER COMMISSIONERS **CODED**
 416 North State Street
 Jackson, Mississippi 39201

WATER WELL DRILLERS LOG

10-31-1974 date well completed
 Lumbkin Well Ser. firm name
 Pearl River county well located

LANDOWNER:
 Southland Development
 Carriere, Mrs.
 (mailing address)

description of formations encountered	from	to
Clay	0	20
Sand	20	70
Clay	70	160
Sand	160	230

WELL LOCATION:
 sec. 8 T. 5 N. R. 16 E.
 3 miles (distance) W. of Carriere (nearest town)

WELL PURPOSE: Home
 (home, irrigation, municipal, industrial)

- WELL COMPLETION DATA:
- (1) diameter (inches) 2"
 - (2) total depth (feet) 230
 - (3) static water level (feet) 20 below top of ground.
 - (4) casing P.V.C. 224' (material) (depth)
 2" (size) if telescope see back.
 - (5) screen 6' 224' (length) (depth to top)
 2" (size) P.V.C. (material)
 - (6) pump 1/2 500 G.P.H. (HP) (yield gpm)
 Elec. (type power)
 - (7) electric log No (yes or no)
 - (organization running log)
 - (8) how well bottom plugged Sand Shrub

CODED


RECEIVED
 DEC - 6 1974

DRILLERS REMARKS:

MISS. BD. OF WATER COMMISSIONERS

If well telescopes please sketch and show depths.

GROUND LEVEL

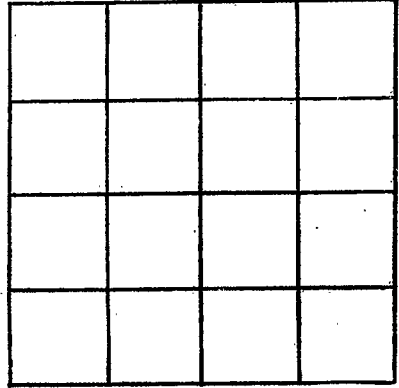

SECTION _____

Please indicate well location X.

ADDITIONAL INFORMATION

If more than one screen,
show locations of each on sketch.