

P.R.  
 VII5  
 11-3-74

MISSISSIPPI  
 BOARD OF WATER COMMISSIONERS  
 416 North State Street  
 Jackson, Mississippi 39201

CODED

WATER WELL DRILLERS LOG

11-3-74 date well completed  
 1974 Lumphin Well Co. firm name  
 Pearl River county well located

LANDOWNER:  
 Southland Development  
 Carriere, Miss.  
 (mailing address)

description of formations encountered	from	to
Clay	0	25
Sand	25	60
Clay	60	150
Sand	150	226

WELL LOCATION:  
 sec. 8 T. 5 N. R. 7 E.  
 3 mi. West of Carriere  
 (distance) (direction) (nearest town)

WELL PURPOSE: Home  
 (home, irrigation, municipal, industrial)

- WELL COMPLETION DATA:
- (1) diameter (inches) 2"
  - (2) total depth (feet) 226'
  - (3) static water level (feet) 20' below top of ground.
  - (4) casing P.V.C. 220'  
 (material) (depth)  
2" If telescope see back.  
 (size)
  - (5) screen 6' 220'  
 (length) (depth to top)  
2" P.V.C.  
 (size) (material)
  - (6) pump 1/2 500 G.P.H.  
 (HP) (yield gpm)  
Elec.  
 (type power)
  - (7) electric log no  
 (yes or no)

(organization running log)  
 (8) how well bottom plugged Sand Plug

DRILLERS REMARKS:


CODED

RECEIVED  
 DEC - 6 1974

MISS. BD. OF WATER COMMISSIONERS

If well telescopes please sketch and show depths.

GROUND LEVEL

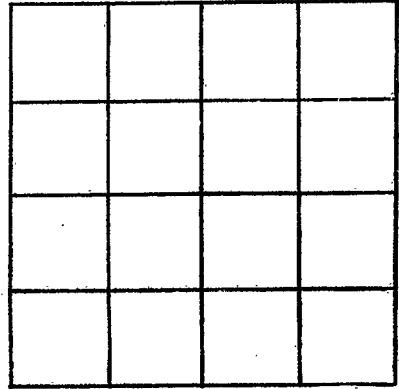

SECTION \_\_\_\_\_

Please indicate well location X.

ADDITIONAL INFORMATION

If more than one screen, show locations of each on sketch.