

P.R.
V 116
11-5-74

MISSISSIPPI
BOARD OF WATER COMMISSIONERS
416 North State Street
Jackson, Mississippi 39201

CODED

WATER WELL DRILLERS LOG

11-5 date well completed 1974 Lumbria Well Co. firm name Pearl River county well located

LANDOWNER:
Southland Development
Carnie, Miss.
(mailing address)

description of formations encountered	from	to
Clay	0	25
Sand	25	60
Clay	100	160
Sand	160	220

WELL LOCATION:
sec. 8 T. 5 N. R. 1 E.
3 miles West of Carnie
(distance) (direction) (nearest town)

WELL PURPOSE: Home
(home, irrigation, municipal, industrial)

- WELL COMPLETION DATA:
- (1) diameter (inches) 2"
 - (2) total depth (feet) 220'
 - (3) static water level (feet) 20' below top of ground.
 - (4) casing P.V.C., 2 1/4"
(material) (depth)
2" (size) If telescope see back.
 - (5) screen 6' 2 1/2"
(length) (depth to top)
2" P.V.C.
(size) (material)
 - (6) pump 1/2 500 G.P.H.
(HP) (yield gpm)
Elec.
(type power)
 - (7) electric log No
(yes or no)

(8) how well bottom plugged Sand & Shale
(organization running log)


DRILLERS REMARKS:

CODED

RECEIVED
DEC 6 1974

If well telescopes please sketch and show depths.

GROUND LEVEL

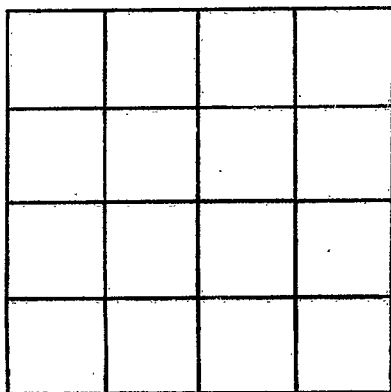

SECTION _____

Please indicate well location X.

ADDITIONAL INFORMATION

If more than one screen, show locations of each on sketch.