

P.R.  
V117  
11-15-74

MISSISSIPPI  
BOARD OF WATER COMMISSIONERS  
416 North State Street  
Jackson, Mississippi 39201

CODED

WATER WELL DRILLERS LOG

11-15 1974 Lumpkin Wells & Pail Lines  
date well completed firm name county well located


LANDOWNER:	description of formations encountered	from	to
<u>Southland Development</u> <u>Carrine, Miss</u> (mailing address)			
	<u>Sand</u>	<u>25</u>	<u>60</u>
	<u>Clay</u>	<u>60</u>	<u>100</u>
	<u>Sand</u>	<u>160</u>	<u>231</u>
<b>WELL LOCATION:</b>			
sec. <u>3</u> T. <u>5</u> N. R. <u>16</u> E. <u>2</u> miles <u>W.</u> of <u>Carrine</u> (distance) (direction) (nearest town)			
<b>WELL PURPOSE:</b> <u>Home</u> (home, irrigation, municipal, industrial)			
<b>WELL COMPLETION DATA:</b>			
(1) diameter (inches) <u>2"</u>			
(2) total depth (feet) <u>231'</u>			
(3) static water level (feet) <u>20'</u> below top of ground.			
(4) casing <u>P.V.C.</u> , <u>225'</u> (material) (depth)			
<u>2"</u> if telescope see back. (size)			
(5) screen <u>6</u> , <u>225'</u> (length) (depth to top)			
<u>2"</u> , <u>P.V.C.</u> (size) (material)			
(6) pump <u>1/2</u> , <u>500 G.P.H.</u> (HP) (yield gpm)			
<u>Elec</u> (type power)			
(7) electric log <u>No</u> (yes or no)			
(organization running log)			
(8) how well bottom plugged <u>Good</u>			
<b>DRILLERS REMARKS:</b>			

CODED

RECEIVED  
DEC - 6 1974

If well telescopes please sketch and show depths.

GROUND LEVEL

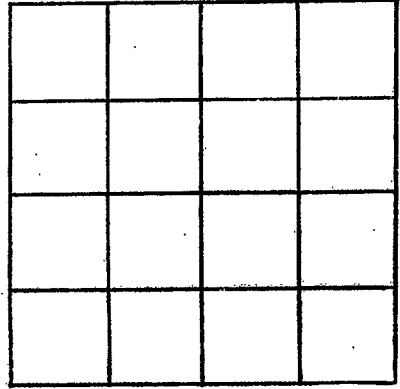

SECTION \_\_\_\_\_

Please indicate well location X.

ADDITIONAL INFORMATION

If more than one screen,  
show locations of each on sketch.