

P.R.  
V 118  
12-16-74

MISSISSIPPI  
BOARD OF WATER COMMISSIONERS  
416 North State Street  
Jackson, Mississippi 39201

WATER WELL DRILLERS LOG CODED

12-16 1974 Lumpha Well Ser Pearl River  
date well completed firm name county well located

LANDOWNER:  
Southland Development Corp.  
Carrere Miss.  
(mailing address)


description of formations encountered	from	to
Clay	0	45
Sand	45	60
Clay	60	320
Sand	320	362

WELL LOCATION:  
sec 3 T N R 10 E  
3 miles W of Carrere  
(distance) (direction) (nearest town)

WELL PURPOSE: Home  
(home, irrigation, municipal, industrial)

- WELL COMPLETION DATA:
- (1) diameter (inches) 2"
  - (2) total depth (feet) 362'
  - (3) static water level (feet) 25' below above top of ground.
  - (4) casing P.V.C., 357',  
(material) (depth)  
2" If telescope see back.  
(size)
  - (5) screen 5, 357'  
(length) (depth to top)  
2", P.V.C.  
(size) (material)
  - (6) pump 1/2, 400 S.P.H.  
(HP) (yield gpm)  
Elec.  
(type power)
  - (7) electric log No.  
(yes or no)
  - (organization running log)
  - (8) how well bottom plugged Small Shrub

CODED

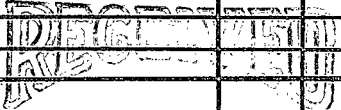


DRILLERS REMARKS:

JAN 22 1975

If well telescopes please sketch and show depths.

GROUND LEVEL

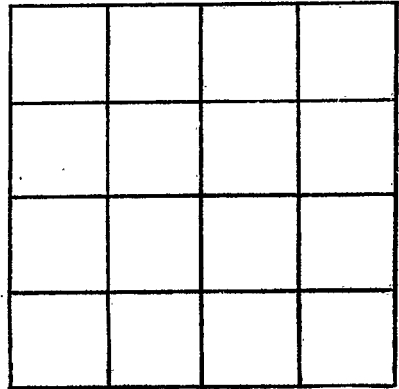

SECTION \_\_\_\_\_

Please indicate well location X.

ADDITIONAL INFORMATION

If more than one screen,  
show locations of each on sketch.