

P.R.  
V119  
12-16-74

MISSISSIPPI  
BOARD OF WATER COMMISSIONERS  
416 North State Street  
Jackson, Mississippi 39201

WATER WELL DRILLERS LOG

12-16 1974 Lumpkin Well Co. Paul River  
date well completed firm name county well located

LANDOWNER:  
Southland Development Corp.  
Carriere, Miss.  
(mailing address)

description of formations encountered	from	to
Clay	0	20
Sand	20	45
Clay	45	130
Sand	130	142

WELL LOCATION:  
sec. 3 T. 5 N. R. 7E  
3 miles W. of Carriere  
(distance) (direction) (nearest town)

WELL PURPOSE: Home  
(home, irrigation, municipal, industrial)

- WELL COMPLETION DATA:
- (1) diameter (inches) 2"
  - (2) total depth (feet) 142
  - (3) static water level (feet) 30' below top of ground.
  - (4) casing P.V.C. 157'  
(material) (depth)  
2" if telescope see back.  
(size)
  - (5) screen 5' 157'  
(length) (depth to top)  
2" P.V.C.  
(size) (material)
  - (6) pump 1/2 400 G.P.H.  
(HP) (yield gpm)  
Elec.  
(type power)
  - (7) electric log No.  
(yes or no)
  - (organization running log)
  - (8) how well bottom plugged Sand Shub


CODED

DRILLERS REMARKS:

DEC 22 1974  
JAN 22 1975

If well telescopes please sketch and show depths.

GROUND LEVEL

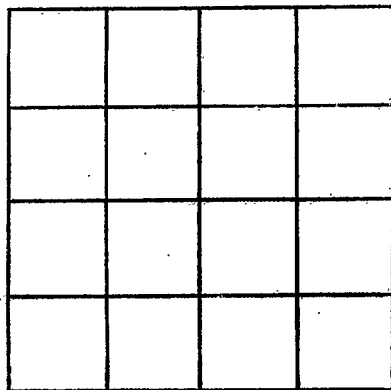

SECTION \_\_\_\_\_

Please indicate well location X.

ADDITIONAL INFORMATION

If more than one screen, show locations of each on sketch.