

Pearl R.
V120
3-10-75

MISSISSIPPI
BOARD OF WATER COMMISSIONERS
416 North State Street
Jackson, Mississippi 39201

CODED

WATER WELL DRILLERS LOG

3-10-1975 date well completed
Lumpkin Well Sec. firm name
Pearl River county well located

LANDOWNER:
Mr. Q. New
Cucher Lake, Corriere, Miss.
(mailing address)

description of formations encountered	from	to
Clay	0	50
Sand	50	65
Clay	65	320
Sand	320	365

WELL LOCATION:
sec. 3 T. 5 N. R. 16 E.
3 miles E of Corriere
(distance) (direction) (nearest town)

WELL PURPOSE: Home
(home, irrigation, municipal, industrial)

- WELL COMPLETION DATA:
- (1) diameter (inches) 9"
 - (2) total depth (feet) 365
 - (3) static water level (feet) 35' below top of ground.
 - (4) casing P.V.C. 360'
(material) (depth)
2" If telescope see back.
(size)
 - (5) screen 5' 360'
(length) (depth to top)
2" P.V.C.
(size) (material)
 - (6) pump 1/2 250 S.P.H.
(HP) (yield gpm)
Elec.
(type power)
 - (7) electric log No.
(yes or no)
 - (8) how well bottom plugged Hand Shovel

CODED


RECEIVED
MAR 26 1975

DRILLERS REMARKS:

MISS. RD. OF WATER COMMISSIONERS

If well telescopes please sketch and show depths.

GROUND LEVEL

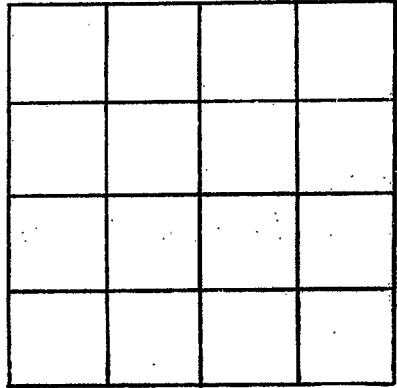

SECTION _____

Please indicate well location X.

ADDITIONAL INFORMATION

If more than one screen, show locations of each on sketch.