

MISSISSIPPI
 BOARD OF WATER COMMISSIONERS
 416 North State Street
 Jackson, Mississippi 39201

CODED

WATER WELL DRILLERS LOG

Pearl R.
 V121
 11-20-74

11-20-74 19
 date well completed

Bud Kenton's son Pearl River
 firm name county well located

LANDOWNER: M. L. Kabel

description of formations encountered

from to

Route 2
Carrine, Miss.
 (mailing address)

<u>White Shale</u>	<u>0</u>	<u>16</u>
<u>White sand</u>	<u>16</u>	<u>24</u>
<u>Blue shale</u>	<u>24</u>	<u>305</u>
<u>Grey sand</u>	<u>305</u>	<u>348</u>

WELL LOCATION:

sec. 9 T. 5 N. R. 16 E.
2 miles (distance) E (direction) of Carrine (nearest town)

WELL PURPOSE: Home
 (home, irrigation, municipal, industrial)

WELL COMPLETION DATA:

CODED

(1) diameter (inches) 2 in.

(2) total depth (feet) 348

(3) static water level (feet) 28 below above top of ground.

(4) casing Galv. 1 3/8
 (material) (depth)

if telescope see back.

(5) screen 2x5 343
 (length) (depth to top)

2x5 Galv. No. 12
 (size) (material)

(6) pump 1/2 450
 (HP) (yield gpm)

electric
 (type power)

(7) electric log NO
 (yes or no)

(organization running log)

(8) how well bottom plugged
Bud Kabel

DRILLERS REMARKS:




APR - 3 1975

MISS. RD. OF WATER COMMISSIONERS

If well telescopes please sketch and show depths.

GROUND LEVEL

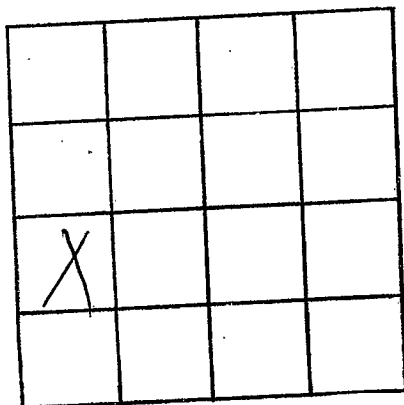

SECTION _____

Please indicate well location X.

ADDITIONAL INFORMATION

If more than one screen, show locations of each on sketch.