

Pearl R.
V122
4-1-75

MISSISSIPPI
BOARD OF WATER COMMISSIONERS
416 North State Street
Jackson, Mississippi 39201

CODED

WATER WELL DRILLERS LOG

4-1 1975 Bud Vinton & Son Pearl River
date well completed firm name county well located

LANDOWNER: S. Jones
Carrum, Miss.
(mailing address)

description of formations encountered	from	to
White shale	0	40
Blue shale	40	180
Blue sand fine	180	220
Blue shale	220	340
Grey sand	340	360

WELL LOCATION:
sec. 9 T. 5 N R. 15 E
2 miles NE of Carrum
(distance) (direction) (nearest town)


WELL PURPOSE: Home
(home, irrigation, municipal, industrial)

WELL COMPLETION DATA:

- (1) diameter (inches) 2
- (2) total depth (feet) 360
- (3) static water level (feet) 33 below top of ground.
- (4) casing PVC 350
(material) (depth)
If telescope see back.
- (5) screen 2x10 350
(length) (depth to top)
2x10 PVC no 10
(size) (material)
- (6) pump 1/2 450
(HP) (yield gpm)
electric
(type power)
- (7) electric log NO
(yes or no)
- (organization running log)

CODED

(8) how well bottom plugged
Sand Shale

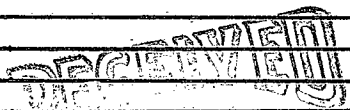


DRILLERS REMARKS:

APR - 3 1975

RD. OF WATER COMMISSIONERS

If well telescopes please sketch and show depths.

GROUND LEVEL

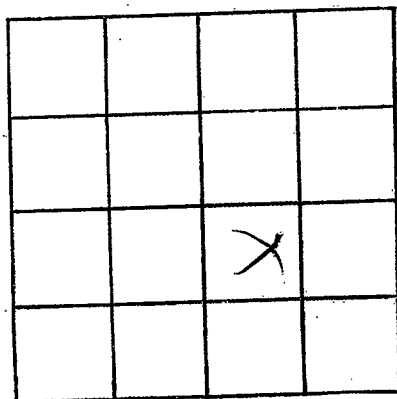

SECTION _____

Please indicate well location X.

ADDITIONAL INFORMATION

If more than one screen,
show locations of each on sketch.