

Pearl R.  
 V123  
 1-5-75

MISSISSIPPI  
 BOARD OF WATER COMMISSIONERS  
 416 North State Street  
 Jackson, Mississippi 39201

WATER WELL DRILLERS LOG CODED

1-6 1975 Penton Well Serv Pearl River  
 date well completed firm name county well located

LANDOWNER: F. W. Whittington	description of formations encountered	from	to
401 Tartan Dr.			
Metairie, La. 70003 (mailing address)	Surface Clay	0	35
	Red Sand	35	56
	White Clay	56	90
	Blue Clay	90	395
	Sand	395	451

WELL LOCATION:  
 sec. 8 T. 5 N. R. 16 E  
 S W  
 2 miles East of Carriere  
 (distance) (direction) (nearest town)

WELL PURPOSE: Home  
 (home, irrigation, municipal, industrial)

- WELL COMPLETION DATA:
- (1) diameter (inches) 2
  - (2) total depth (feet) 451
  - (3) static water level (feet) 90 below  
 top of ground.
  - (4) casing Galv., 431,  
 (material) (depth)  
 2 If telescope see back.  
 (size)
  - (5) screen 10', 431  
 (length) (depth to top)  
 2, S. Steel  
 (size) (material)
  - (6) pump 1 6  
 (HP) (yield gpm)  
 Elec  
 (type power)
  - (7) electric log NO  
 (yes or no)

(organization running log)  
 (8) how well bottom plugged B.W. Valve

DRILLERS REMARKS:


CODE

REGISTERED  
 APR 10 1975

MISS. BD. OF WATER COMMISSIONERS

If well telescopes please sketch and show depths.

GROUND LEVEL

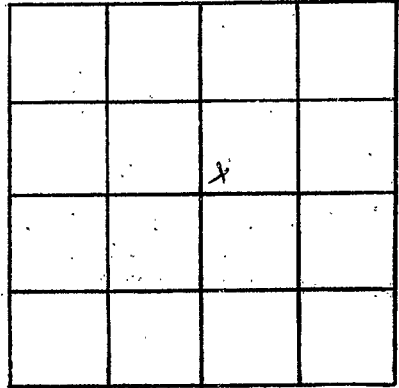

SECTION 8

Please indicate well location X.

ADDITIONAL INFORMATION

If more than one screen,  
show locations of each on sketch.