

Pearl River
 V 124
 7-3-75

MISSISSIPPI
 BOARD OF WATER COMMISSIONERS
 416 North State Street
 Jackson, Mississippi 39201

CODED

WATER WELL DRILLERS LOG

7-3 1975 Pumphkin Wells Pearl River
 date well completed firm name county well located

LANDOWNER:	description of formations encountered	from	to
<u>Mr. H.T. Byrd</u>			
<u>Laurel, Miss</u> (mailing address)			
WELL LOCATION:			
sec. <u>9</u> T. <u>N</u> R. <u>10E</u> <u>3</u> miles <u>East</u> of <u>Lauriere</u> (distance) (direction) (nearest town)			
WELL PURPOSE: <u>Home</u> (home, irrigation, municipal, industrial)			
WELL COMPLETION DATA:			
(1) diameter (inches) <u>2"</u>			
(2) total depth (feet) <u>380'</u>			
(3) static water level (feet) <u>18'</u> below top of ground.			
(4) casing <u>P.V.C.</u> , <u>374'</u> (material) (depth) <u>2"</u> if telescope see back. (size)			
(5) screen <u>6'</u> , <u>374'</u> (length) (depth to top) <u>2"</u> , <u>P.V.C.</u> (size) (material)			
(6) pump <u>1/2</u> , <u>250</u> (HP) (yield gpm) <u>Elec.</u> (type power)			
(7) electric log <u>No</u> (yes or no) <u>No</u> (organization running log)			
(8) how well bottom plugged <u>Sand Shrub</u>			
DRILLERS REMARKS:			


Clay	0	15
Sand	15	25
Clay	25	180
Fine Sand	180	205
Clay	205	340
Sand	340	380

RECEIVED
 RECEIVED

MAR 14 1975
 APR 14 1975

If well telescopes please sketch and show depths.

GROUND LEVEL

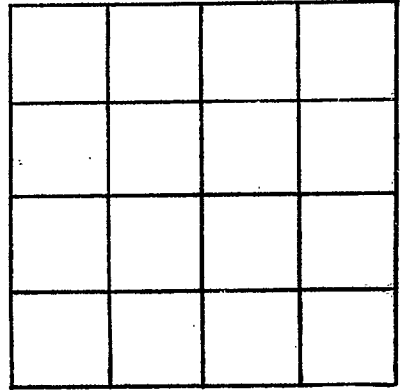

SECTION _____

Please indicate well location X.

ADDITIONAL INFORMATION

If more than one screen, show locations of each on sketch.