

Pearl River
V 125
8-30-75

MISSISSIPPI
 BOARD OF WATER COMMISSIONERS
 416 North State Street
 Jackson, Mississippi 39201

CODED

WATER WELL DRILLERS LOG

8-30 1975 Penton Well Serv Pearl River
 date well completed firm name county well located


LANDOWNER: <u>Wayne Mancuso</u>	description of formations encountered	from	to
<u>Picayune Miss</u> (mailing address)	<u>Surface Clay</u>	<u>0</u>	<u>35</u>
WELL LOCATION: sec. <u>32</u> T. <u>5</u> S. R. <u>16</u> E. ¹³⁰	<u>Sand</u>	<u>35</u>	<u>60</u>
<u>2</u> miles <u>NE</u> of <u>Picayune</u> (distance) (direction) (nearest town)	<u>White Clay</u>	<u>60</u>	<u>85</u>
WELL PURPOSE: <u>Home</u> (home, irrigation, municipal, industrial)	<u>Blue Clay</u>	<u>85</u>	<u>490</u>
WELL COMPLETION DATA:	<u>Sand</u>	<u>490</u>	<u>560</u>
(1) diameter (inches) <u>4 x 2</u>	CODED		
(2) total depth (feet) <u>560</u>			
(3) static water level (feet) <u>26</u> below top of ground.	MISS. BU. OF WATER COMMISSIONERS		
(4) casing <u>Galv.</u> <u>560</u> (material) (depth)			
<u>4 x 2</u> If telescope see back. (size)	MISS. BU. OF WATER COMMISSIONERS		
(5) screen <u>15'</u> <u>545</u> (length) (depth to top)			
(6) pump <u>1/2</u> <u>14</u> (HP) (yield gpm)	MISS. BU. OF WATER COMMISSIONERS		
<u>Elec</u> (type power)			
(7) electric log <u>NO</u> (yes or no)	MISS. BU. OF WATER COMMISSIONERS		
(organization running log)			
(8) how well bottom plugged <u>Brill Valve</u>	MISS. BU. OF WATER COMMISSIONERS		
DRILLERS REMARKS:			

If well telescopes please sketch and show depths.

GROUND LEVEL

105 Ft 4"

455 Ft. 2"

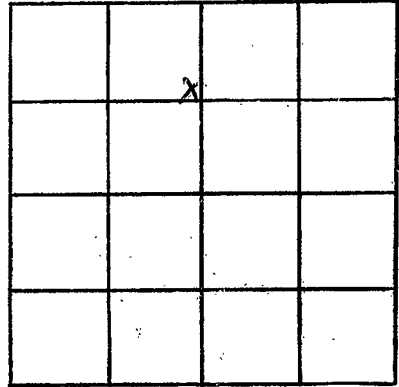

SECTION 32

Please indicate well location X.

ADDITIONAL INFORMATION

If more than one screen, show locations of each on sketch.