

Pearl River
V 126
6-27-75

MISSISSIPPI
 BOARD OF WATER COMMISSIONERS
 416 North State Street
 Jackson, Mississippi 39201

WATER WELL DRILLERS LOG

6/27 1975 Bud Benton & Son Pearl River
 date well completed firm name county well located

LANDOWNER: Al Freeman
Picayune Miss.

description of formations encountered	from	to
<u>Red Shale</u>	<u>0</u>	<u>18</u>
<u>Red sand</u>	<u>18</u>	<u>42</u>
<u>Blue Shale</u>	<u>42</u>	<u>470</u>
<u>dry sand</u>	<u>570</u>	<u>572</u>

(mailing address)

WELL LOCATION:
 sec. 29 T. 5 N R. 16 E
2 1/2 miles NEAST of Picayune
 (distance) (direction) (nearest town)

WELL PURPOSE:
 (home, irrigation, municipal, industrial)

WELL COMPLETION DATA:


- (1) diameter (inches) 2"
- (2) total depth (feet) 572
- (3) static water level (feet) 21 below top of ground.
- (4) casing PVC, 572
 (material) (depth)
 (size) if telescope see back.
- (5) screen 2x10, 572
 (length) (depth to top)
12, PVC
 (size) (material)
- (6) pump 1 660
 (HP) (yield gpm)
Chat
 (type power)
- (7) electric log no
 (yes or no)
- (organization running log)
- (8) how well bottom plugged hard
short

DRILLERS REMARKS:

OCT 20 1975
 MISS. RD. DEPT. WATER COMMISSIONERS

If well telescopes please sketch and show depths.

GROUND LEVEL

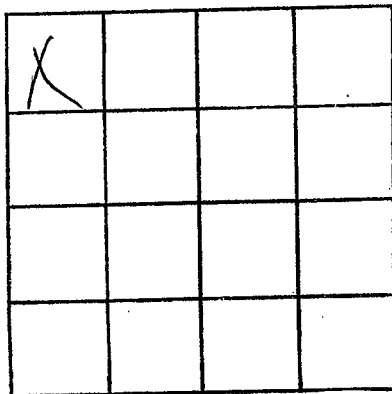

SECTION _____

Please indicate well location X.

ADDITIONAL INFORMATION

If more than one screen, show locations of each on sketch.