

Pearl River  
 V 127  
 8-12-75

MISSISSIPPI  
 BOARD OF WATER COMMISSIONERS  
 416 North State Street  
 Jackson, Mississippi 39201

WATER WELL DRILLERS LOG

8-12 date well completed      13V 25 Lempkin Well Sec. firm name      Pearl River county well located

LANDOWNER:  
 Betty Stewart  
 Rt. Picayune, Miss.  
 (mailing address)

description of formations encountered	from	to
Clay	0	30
Sand	30	120
Clay	120	230
Sand	230	283

WELL LOCATION:  
 sec. 29 T 5 N R 17 E  
 6 miles N.E. of Picayune  
 (distance) (direction) (nearest town)

WELL PURPOSE: Home  
 (home, irrigation, municipal, industrial)


- WELL COMPLETION DATA:
- (1) diameter (inches) 2"
  - (2) total depth (feet) 283'
  - (3) static water level (feet) 700' below top of ground.
  - (4) casing P.V.C. 278'  
 (material) (depth)  
2" If telescope see back.  
 (size)
  - (5) screen 5' 278'  
 (length) (depth to top)  
2" P.V.C.  
 (size) (material)
  - (6) pump 1 450  
 (HP) (yield gpm)  
Elec.  
 (type power)
  - (7) electric log No.  
 (yes or no)  
No.  
 (organization running log)
  - (8) how well bottom plugged Good Shrub

DRILLERS REMARKS:

MISSISSIPPI BOARD OF WATER COMMISSIONERS  
 OCT 24 1975  
 MISS. Bd. OF WATER COMMISSIONERS

If well telescopes please sketch and show depths.

GROUND LEVEL

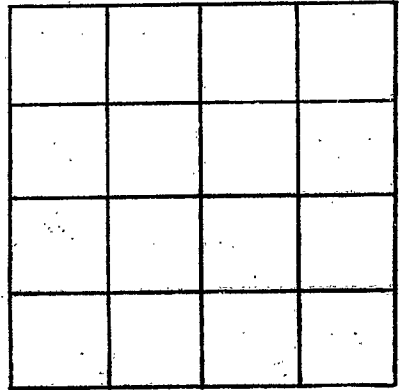

SECTION \_\_\_\_\_

Please indicate well location X.

ADDITIONAL INFORMATION

If more than one screen, show locations of each on sketch.