

Pearl River  
 V 131  
 4-29-80

MISSISSIPPI DEPARTMENT OF NATURAL RESOURCES  
 Bureau of Land and Water Resources  
 Southport Mall  
 P.O. Box 10631  
 Jackson, Mississippi 39209  
 WATER WELL DRILLERS LOG

CODED

4-29 1980 Penton Well Serv Pearl River  
 date well completed firm name county well located

LANDOWNER: Raymond Lossett

RT

Carriere, MS.  
 (mailing address)

WELL LOCATION:

sec. 33 T 5 S R 16 E W  
3 miles N.E. of Piczyane  
 (distance) (direction) (nearest town)

WELL PURPOSE: Home  
 (home, irrigation, municipal, industrial)

WELL COMPLETION DATA:

- (1) diameter (inches) 2
- (2) total depth (feet) 523
- (3) static water level (feet) flow <sup>below</sup> above top of ground.
- (4) casing Galv 513  
 (material) (depth)  
2 if telescope see back.  
 (size)
- (5) screen 10' 513  
 (length) (depth to top)  
2 S. Steel  
 (size) (material)
- (6) pump 1/2 14  
 (HP) (yield gpm)  
Elec  
 (type power)
- (7) electric log NO  
 (yes or no)

(organization running log)

(8) how well bottom plugged B.W. Valve

description of formations encountered	from	to
Surface Clay	0	13
Sand	13	30
Clay	30	160
Silt	160	190
Clay	190	470
Sand	470	523

CODED

DEPT. OF NATURAL RESOURCES  
 BUREAU OF LAND & WATER RESOURCES


JUN 3 - 1980

RECEIVED

DRILLERS REMARKS:

If well telescopes please  
sketch and show depths.

GROUND LEVEL

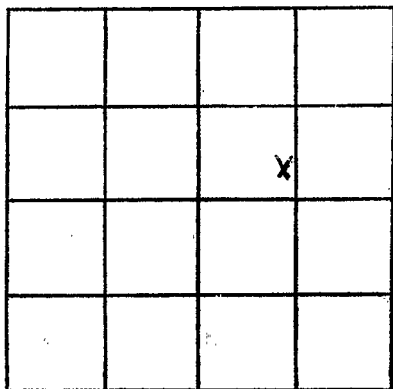

SECTION 33

Please indicate well location X.

ADDITIONAL INFORMATION

If more than one screen,  
show locations of each on sketch.