

Pearl River
 V133
 - 8/

MISSISSIPPI
 BOARD OF WATER COMMISSIONERS
 416 North State Street
 Jackson, Mississippi 39201

CODED

WATER WELL DRILLERS LOG

19 81 Pentoni Well Serv Pearl River
 date well completed firm name county well located

LANDOWNER: Jack Lossett
McNeil MS.
School teacher Carrere
 (mailing address)

description of formations encountered	from	to
Surface Clay	0	15
Sand	15	30
Clay	30	460
Sand	460	640

WELL LOCATION:
 sec. 33 T 5 N R 16 E
3 miles N.E. of Pozyane
 (distance) (direction) (nearest town)

CODED

WELL PURPOSE: Home
 (home, irrigation, municipal, industrial)

- WELL COMPLETION DATA:
- diameter (inches) 2
 - total depth (feet) 640
 - static water level (feet) 1 above top of ground.
 - casing Galv 630
 (material) (depth)
2 if telescope see back.
 (size)
 - screen 10' 630
 (length) (depth to top)
2 S. Steel
 (size) (material)
 - pump ✓ ✓
 (HP) (yield gpm)
✓
 (type power)
 - electric log No
 (yes or no)
 (organization running log)
 - how well bottom plugged BW

~~NO~~

~~PUMP~~


DEPT. OF NATURAL RESOURCES
 BUREAU OF LAND & WATER RESOURCES

RECEIVED
 MAY 1991

DRILLERS REMARKS:

If well telescopes please sketch and show depths.

GROUND LEVEL

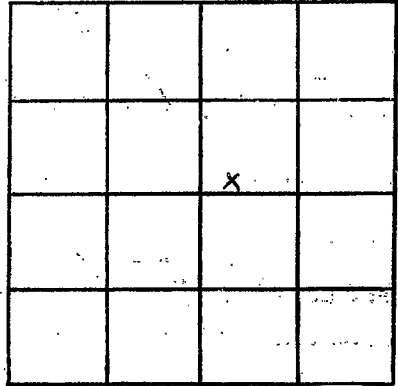

SECTION 33

Please indicate well location X.

ADDITIONAL INFORMATION

If more than one screen, show locations of each on sketch.