

Pearl R.

WATER WELL DRILLERS LOG

V 2000

Date: 11-24, 1961, Driller: J. Beard County: Pearl River

11-24-61

(Name)

(1) Owner of Land: Edw W. Olson
(Name)

RT 1 Carriere Min
(Address)

(2) Location: 100 1/2 NE 1/4, Sec 27 T5 R16E

1 miles North, of Coran
(distance) (direction) (Nearest Town)

(3) Topography: (Hilly) (Flat) (Level)

(4) Purpose of Well: Home
(Domestic Irrigation, Municipal, Industrial, Other)

Description & Color of Materials Sand, Clay, Red Clay, Shell, etc.	Thick- ness Feet	Depth Feet
<u>Red Clay & mud</u>	<u>40</u>	<u>40</u>
<u>white sand & shell</u>	<u>63</u>	<u>103</u>
<u>Blue mud</u>	<u>122</u>	<u>225</u>
<u>fine sand</u>	<u>40</u>	<u>265</u>
<u>Hard Blue Tramp</u>	<u>150</u>	<u>410</u>
<u>Stratton</u>	<u>37</u>	<u>447</u>

Information upon completion of well:

(1) Diameter: 2" x 1 1/2" inches.

(2) Total Depth: 447 feet.

(3) Water Level: 70 feet below top of ground.

(4) Cased to _____, Size _____


(5) Screen: Size 1/4, Length 25 ft

(6) Were any formations sealed against pollution?
Back filled with white sand
yes, _____ no.

If YES depth of formation _____

Why _____

Drillers Remarks: _____

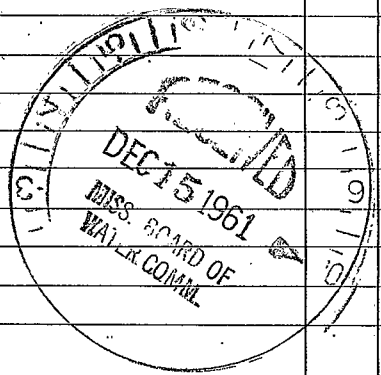

(Use Back Side)

Well No.

Retain this copy for your office files.

