

V 2005

8-15-64

WATER WELL DRILLERS LOG

Date: 8-15, 1964, Driller: J. Beal County Pearl River
 (Name)

(1) Owner of Land: J. Fred Pearson
 (Name)

Rt 2 Box 122 Carriere Miss
 (Address)

(2) Location: SE 1/4, NE 1/4, Sec. 23 T5 R 16

4 miles North, of Pearl
 (distance) (direction) (Nearest Town)

(3) Topography: (Hilly) (Flat) (Level)

(4) Purpose of Well: Home
 (Domestic Irrigation, Municipal, Industrial, Other)

Description & Color of Materials Sand, Clay, Red Clay, Shell, etc.	Thick- ness Feet	Depth Feet
<u>Soft mud & sand</u>	<u>110</u>	<u>110</u>
<u>Hard Blue mud</u>	<u>240</u>	<u>350</u>
<u>Fine sand</u>	<u>30</u>	<u>380</u>
<u>Water sand</u>	<u>63</u>	<u>443</u>

Information upon completion of well:

(1) Diameter 2" x 1 1/4" inches.

(2) Total Depth 443 feet.

(3) Water Level 80 feet below top of ground.

(4) Cased to _____, Size _____.


(5) Screen: Size 1 1/4", Length 15'.

(6) Were any formations sealed against pollution?
 _____ yes, _____ no.

If YES depth of formation _____.

Why _____.

Drillers Remarks: _____.

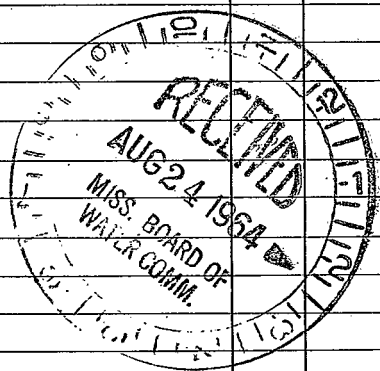

(Use Back Side)

Well No.

