

V 2006
12-8-64

WATER WELL DRILLERS LOG

Date: 12-8, 1964, Driller: J. Bevell County: Harrison *Pearl River*

(Name)

(1) Owner of Land: Forrest Son
(Name)
Rt 3 Peayune mi
(Address)

(2) Location: SW 1/4, SW 1/4, Sec. 3, T5 R16E
in Cesar miss
miles _____, of _____
(distance) (direction) (Nearest Town)

(3) Topography: (Hilly) (Flat) (Level)

(4) Purpose of Well: Home
(Domestic Irrigation
Municipal, Industrial, Other)

Description & Color of Materials Sand, Clay, Red Clay, Shell, etc.	Thick- ness Feet	Depth Feet
<u>Red Clay + sand</u>	<u>45</u>	<u>45</u>
<u>white sand</u>	<u>30</u>	<u>75</u>
<u>soft mud</u>	<u>60</u>	<u>135</u>
<u>Half Blue mud</u>	<u>40</u>	<u>175</u>
<u>Fine Blue sand</u>	<u>60</u>	<u>235</u>
<u>Half Blue mud</u>	<u>70</u>	<u>305</u>
<u>Water sand</u>	<u>54</u>	<u>359</u>

Information upon completion of well:

(1) Diameter: 2" 1/4" inches.

(2) Total Depth: 359 feet.

(3) Water Level: 70 feet below top of ground.

(4) Cased to _____, Size _____

(5) Screen: Size: 1/4", Length: 15 ft


(6) Were any formations sealed against pollution?
60 gauge screen

_____ yes, _____ no.

If YES depth of formation _____

Why _____

Drillers Remarks: _____

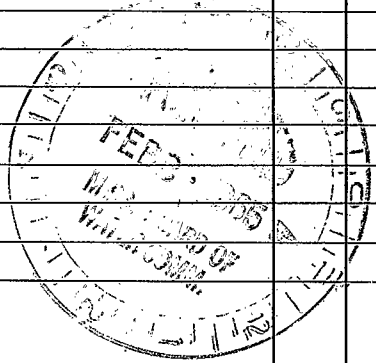

(Use Back Side)

Well No.

