

V 2007

WATER WELL DRILLERS LOG

6-3-66

Date: June 3, 1966, Driller: L. Beach County Pearl River (Name)

(1) Owner of Land: Carl Ralph (Name) Cesar, Miss. (Address) (2) Location: NE 1/4, SE 1/4, Sec. 16 T5R16 (3) Topography: (Hilly) (Flat) (Level) (4) Purpose of Well: Home (Domestic Irrigation Municipal, Industrial, Other)


Table with 3 columns: Description & Color of Materials, Thickness Feet, Depth Feet. Rows include Red mud, sand & gravel, Blue Bending, fine sand, Blue Bend, sand strata.

Information upon completion of well:

(1) Diameter 2 1/4 inches. (2) Total Depth 463 feet. (3) Water Level 70 feet below top of ground. (4) Cased to, Size. (5) Screen: Size 1 1/4, Length 15. (6) Were any formations sealed against pollution? yes, no.

If YES depth of formation. Why.

Drillers Remarks:

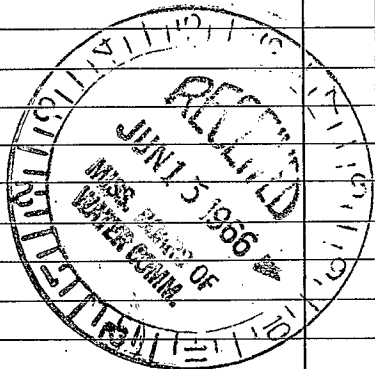

(Use Back Side)

Well No.

