

V 2011

9-66

WATER WELL DRILLERS LOG

Date: 9-9, 19 66, Driller: Walter Patton County Pearl River

(Name)

(1) Owner of Land: Jessie Glidewell  
(Name)

Rt. 2 Carrere, Miss  
(Address)

(2) Location: SE 1/4, SW 1/4, Sec. 12 T 5 R 16 W

11 miles N. E, of Pearl River  
(distance) (direction) (Nearest Town)

(3) Topography: Hilly  
(Hilly) (Flat) (Level)

(4) Purpose of Well: DOMESTIC  
(Domestic Irrigation  
Municipal, Industrial, Other)

Description & Color of Materials  
Sand, Clay, Red Clay, Shell, etc.

Thick-  
ness  
Feet

Depth  
Feet

<u>Clay</u>	<u>38</u>	<u>0-38</u>
<u>Red sand</u>	<u>18</u>	<u>56</u>
<u>sand + gravel</u>	<u>29</u>	<u>85</u>

Information upon completion of well:

(1) Diameter 2 inches.

(2) Total Depth 85 feet.

(3) Water Level 47 feet below top of ground.

(4) Cased to 80, Size 2"

(5) Screen: Size 2" .012, Length 5'


(6) Were any formations sealed against pollution?

       yes,        no.

If YES depth of formation       

Why       

Drillers Remarks:       

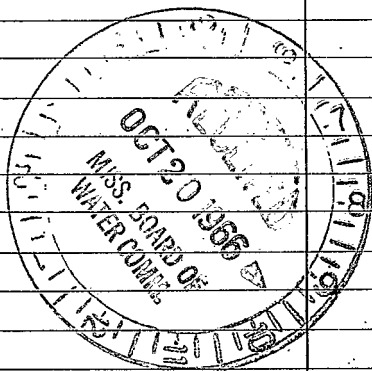

(Use Back Side)

Well No.

