

Pearl River

V 2012

4-67

MISSISSIPPI  
 BOARD OF WATER COMMISSIONERS  
 416 North State Street  
 Jackson, Mississippi 39201

WATER WELL DRILLERS LOG

4-5 1967 Penton Well Serv Pearl River  
 date well completed firm name county well located

LANDOWNER: Lottie Wall

Rt. 3 NO Box #

Picayune, MISS  
(mailing address)

WELL LOCATION:

sec. 34 T 5 S R 16 W

5 miles NE of Picayune  
(distance) (direction) (nearest town)

WELL PURPOSE: Home  
(home, irrigation, municipal, industrial)

WELL COMPLETION DATA:

(1) diameter (inches) 2

(2) total depth (feet) 437

(3) static water level (feet) 29 below top of ground.

(4) casing Galv Steel 432  
(material) (depth)

✓ if telescope see back.  
(size)

(5) screen 5' 432  
(length) (depth to top)

.012 2" S Steel  
(size) (material)

(6) pump 1 720  
(HP) (yield gpm)

Elec  
(type power)

(7) electric log NO  
(yes or no)

(organization running log)


(8) how well bottom plugged BW Valve

DRILLERS REMARKS:

description of formations encountered

from to

Surface Clay	0	26
Sand	26	55
Blue Clay	55	146
Yellow Sand	146	168
Blue Clay	168	217
Fine Grey Sand	217	240
Blue Clay	240	412
Grey Sand	412	437

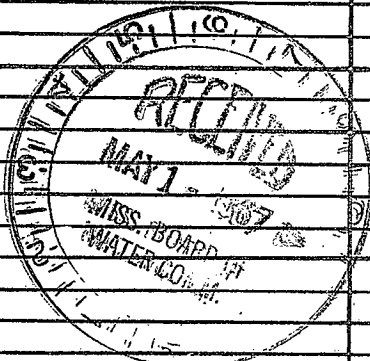

If well telescopes please sketch and show depths.

GROUND LEVEL

			X

SECTION 34

Please indicate well location X.

ADDITIONAL INFORMATION

If more than one screen, show locations of each on sketch.