

Pearl River
 V 2013
 4-67

MISSISSIPPI
 BOARD OF WATER COMMISSIONERS
 416 North State Street
 Jackson, Mississippi 39201

WATER WELL DRILLERS LOG

4-7 1967 Penton Well Serv Pearl River
 date well completed firm name county well located

LANDOWNER: Joe Weems

Rt 3 Box 141

Picayune, MISS
 (mailing address)

description of formations
 encountered

from to

Surface Clay 0 26

Sand 26 57

Blue Clay 57 228

Fine Grey Sand 228 235

Blue Clay 235 438

Grey Sand 438 466

WELL LOCATION:

sec. 34 T 5 S R 16 W
 5 miles N.E. of Picayune
 (distance) (direction) (nearest town)

WELL PURPOSE: Home
 (home, irrigation, municipal, industrial)

WELL COMPLETION DATA:

(1) diameter (inches) 2"

(2) total depth (feet) 466

(3) static water level (feet) 33 ^{below} _{above}
 top of ground. Below

(4) casing Galv Steel, 461
 (material) (depth)

If telescope see back.
 (size)

(5) screen 5' 461
 (length) (depth to top)

.012 2" S. Steel
 (size) (material)

(6) pump 1 720
 (HP) (yield gpm)


Elec
 (type power)

(7) electric log NO
 (yes or no)

(organization running log)

(8) how well bottom plugged BW Valve

DRILLERS REMARKS:

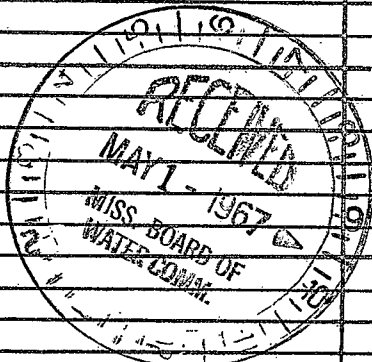

If well telescopes please sketch and show depths.

GROUND LEVEL

			X

SECTION 34

Please indicate well location X.

ADDITIONAL INFORMATION

If more than one screen, show locations of each on sketch.