

Pearl River  
 V2016  
 6-67

MISSISSIPPI  
 BOARD OF WATER COMMISSIONERS  
 416 North State Street  
 Jackson, Mississippi 39201

WATER WELL DRILLERS LOG

6-10 1967 Penton Well Serv Pearl River  
 date well completed firm name county well located

LANDOWNER: Dale Seal  
 New No Box

Rt. 3

description of formations encountered

from to

Picayune Miss  
 (mailing address)

Red clay

0 20

" Sand

20 70

Blue clay

70 195

Grey sand

195 237

WELL LOCATION:

sec 36 T 5 S R 16 W  
 1 1/2 miles South of Caesar  
 (distance) (direction) (nearest town)

WELL PURPOSE: Home  
 (home, irrigation, municipal, industrial)

WELL COMPLETION DATA:

(1) diameter (inches) 2"

(2) total depth (feet) 237

(3) static water level (feet) 57 below top of ground.

(4) casing Galv 232'  
 (material) (depth)

if telescope see back.  
 (size)

(5) screen 5' 232'  
 (length) (depth to top)

012 2" S. Steel  
 (size) (material)

(6) pump 1 360 GPH  
 (HP) (yield gpm)


Elec  
 (type power)

(7) electric log No  
 (yes or no)

(organization running log)


(8) how well bottom plugged BW Valve

DRILLERS REMARKS:

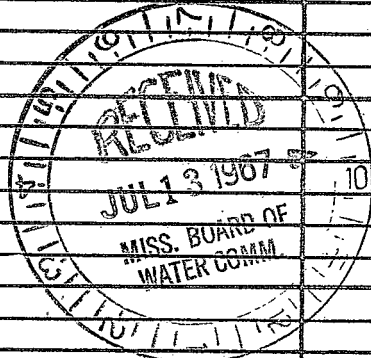

If well telescopes please sketch and show depths.

GROUND LEVEL

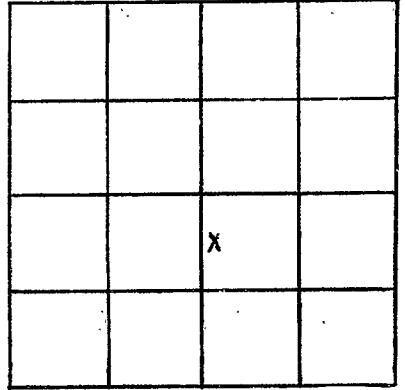

SECTION 36

Please indicate well location X.

ADDITIONAL INFORMATION

If more than one screen, show locations of each on sketch.