

Pearl River
 12007
 6-67

MISSISSIPPI
 BOARD OF WATER COMMISSIONERS
 416 North State Street
 Jackson, Mississippi 39201

WATER WELL DRILLERS LOG

6-22 1967 Penlon Well Serv Pearl River
 date well completed firm name county well located

LANDOWNER: Harry Stockstill

Rt. #2 ~~Box~~ Box 1915

Carriere Miss
 (mailing address)

description of formations
 encountered

from to

Ked Clay	0	20
" Sand	20	75
Blue Clay	75	393
Grey Sand	393	427

WELL LOCATION:

sec. 24 T. 5 S. R. 16 W.
2 miles NW of Carriere
 (distance) (direction) (nearest town)

WELL PURPOSE: Home
 (home, irrigation, municipal, industrial)

WELL COMPLETION DATA:

(1) diameter (inches) 2"
 (2) total depth (feet) 427
 (3) static water level (feet) 88 below top of ground.
 (4) casing Celv, 422'
 (material) (depth)

_____ If telescope see back.
 (size)

(5) screen 5', 422'
 (length) (depth to top)

012 2", S. steel
 (size) (material)

(6) pump 1 7
 (HP) (yield gpm)


Elec
 (type power)

(7) electric log NO
 (yes or no)

_____ (organization running log)

(8) how well bottom plugged BW Valve

DRILLERS REMARKS:

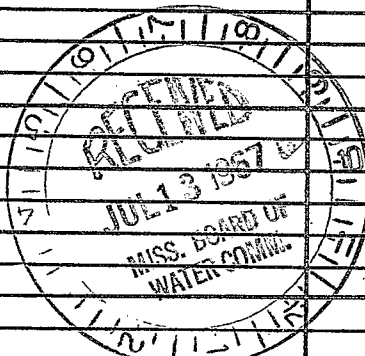

If well telescopes please sketch and show depths.

GROUND LEVEL

x			

SECTION 24

Please indicate well location X.

ADDITIONAL INFORMATION

If more than one screen, show locations of each on sketch.