

Pearl River
V2018
6-67

MISSISSIPPI
BOARD OF WATER COMMISSIONERS
416 North State Street
Jackson, Mississippi 39201

WATER WELL DRILLERS LOG

6-30 1967 Penton Well Serv Pearl River
date well completed firm name county well located

LANDOWNER: Lamar Jones

Rt. 2 Box 192

Carriere Miss
(mailing address)

description of formations encountered

from to

Red clay	0	22
" Sand	22	73
White clay	73	92
Blue clay	92	380
Grey sand	380	423

WELL LOCATION:

sec. 24 T 5 S R. 16 W
2 miles NW of Coazar
(distance) (direction) (nearest town)

WELL PURPOSE: Home
(home, irrigation, municipal, industrial)

WELL COMPLETION DATA:

(1) diameter (inches) 2"
(2) total depth (feet) 423
(3) static water level (feet) 87 below
top of ground.

(4) casing C210, 418
(material) (depth)

_____ if telescope see back.
(size)

(5) screen 5', 418
(length) (depth to top)

012 2", S. Steel
(size) (material)

(6) pump NO ✓
(HP) (yield gpm)

✓
(type power)


(7) electric log NO
(yes or no)

_____ (organization running log)

(8) how well bottom plugged BW Valve

DRILLERS REMARKS:

NO Pump Set

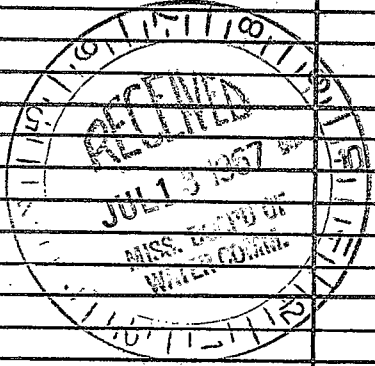

If well telescopes please sketch and show depths.

GROUND LEVEL

X			

SECTION 24

Please indicate well location X.

ADDITIONAL INFORMATION

If more than one screen, show locations of each on sketch.