

Pearl River
 V 200A
 7-67

MISSISSIPPI
 BOARD OF WATER COMMISSIONERS
 416 North State Street
 Jackson, Mississippi 39201

WATER WELL DRILLERS LOG

7-21 1967 Penton Well Serv Pearl River
 date well completed firm name county well located

LANDOWNER: Estes Mitchell

Rt 3 Box 154
 Piquette Miss
 (mailing address)

WELL LOCATION:
 sec. 26 T. 5 S. R. 16 W.
1 miles West of Cesar
 (distance) (direction) (nearest town)

WELL PURPOSE: Home
 (home, irrigation, municipal, industrial)

WELL COMPLETION DATA:
 (1) diameter (inches) 4 1/2 Drilled
 (2) total depth (feet) 237
 (3) static water level (feet) 74 below top of ground.
 (4) casing Galv. Steel 232
 (material) (depth)

if telescope see back.
 (size)

(5) screen 5' 232
 (length) (depth to top)
 012 2" S. Steel
 (size) (material)


(6) pump 1 6
 (HP) (yield gpm)
Elec
 (type power)

(7) electric log NO
 (yes or no)
 (organization running log)

(8) how well bottom plugged B.W. Valve


DRILLERS REMARKS:

description of formations encountered	from	to
Red Clay	0	22
Sand	22	45
White Clay	45	90
White Sand	90	128
Blue Clay	128	206
Grey Sand	206	237

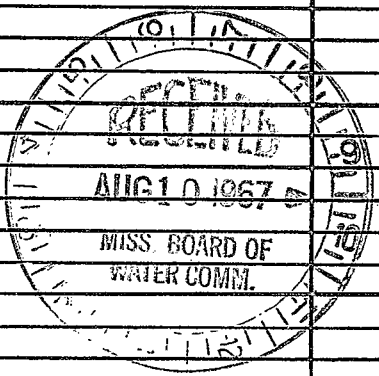

If well telescopes please sketch and show depths.

GROUND LEVEL

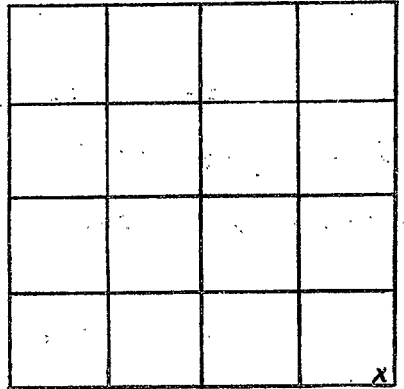

SECTION 26

Please indicate well location X.

ADDITIONAL INFORMATION

If more than one screen,
show locations of each on sketch.