


Pearl River
 V 2001
 10-67

MISSISSIPPI
 BOARD OF WATER COMMISSIONERS
 416 North State Street
 Jackson, Mississippi 39201-1967

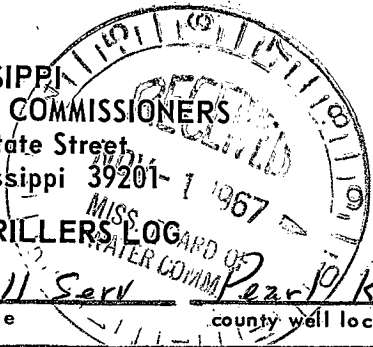

WATER WELL DRILLERS LOG

10-20-67 date well completed
 1967 Penlon Well Serv firm name
 Pearl River county well located

LANDOWNER: Raymond Jones
Rh 2
New - No Box

description of formations encountered	from	to
Red Clay	0	32
" Sand	32	68
White Sand	68	85
" Clay	85	92
Blue Clay	92	186
Five Grey sand	186	212
Blue Clay	212	290
Grey sand	290	320

Carriere MISS-
 (mailing address)

WELL LOCATION:
 sec. 24 T 5 S R 16 W
1 1/2 miles North of Cesar
 (distance) (direction) (nearest town)

WELL PURPOSE: Home
 (home, irrigation, municipal, industrial)

WELL COMPLETION DATA:

- (1) diameter (inches) 4 1/2" Drilled
- (2) total depth (feet) 320
- (3) static water level (feet) 87 below top of ground.
- (4) casing Galv steel 315,
 (material) (depth)
2" if telescope see back.
 (size)
- (5) screen 5', 315
 (length) (depth to top)
D12 - 2", 3. Steel
 (size) (material)
- (6) pump 1 1/2, 6
 (HP) (yield gpm)
Elec
 (type power)
- (7) electric log NO
 (yes or no)
- (organization running log)
- (8) how well bottom plugged B.W. Valve

DRILLERS REMARKS:

If well telescopes please sketch and show depths.

GROUND LEVEL

			X

SECTION 24

Please indicate well location X.

ADDITIONAL INFORMATION

If more than one screen,
show locations of each on sketch.