

Pearl River
 V 2002
 11-67

MISSISSIPPI
 BOARD OF WATER COMMISSIONERS
 416 North State Street
 Jackson, Mississippi 39201

WATER WELL DRILLERS LOG

11-28 1967 Penon Well Serv Pearl River
 date well completed firm name county well located

LANDOWNER: Ralph Miller
Rt. 3 Box 60 A
Picayune MISS-
 (mailing address)

description of formations encountered	from	to
Red Clay	0	26
Red Sand	26	44
White clay	44	65
Blue clay	65	190
Grey Sand	190	216


WELL LOCATION:
 sec. 25 T. 5 S. R. 16 W.
6 miles NE of Picayune
 (distance) (direction) (nearest town)

WELL PURPOSE: Home
 (home, irrigation, municipal, industrial)

WELL COMPLETION DATA:


- (1) diameter (inches) 4 1/2"
- (2) total depth (feet) 216
- (3) static water level (feet) 67 below top of ground.
- (4) casing Galv. steel 2 1/2" (material) (depth)
2" if telescope see back. (size)
- (5) screen 5' (length) 211' (depth to top)
2" (size) St. Steel (material)
- (6) pump 1 (HP) 6 (yield gpm)
Elec (type power)
- (7) electric log No (yes or no)
 (organization running log)
- (8) how well bottom plugged B.W. Valve

DRILLERS REMARKS:

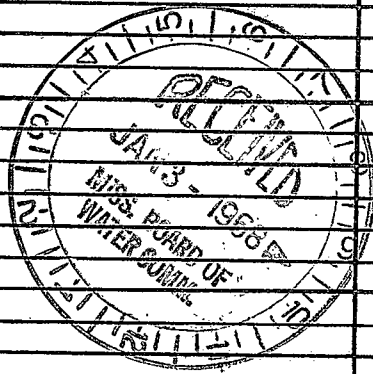

If well telescopes please sketch and show depths.

GROUND LEVEL

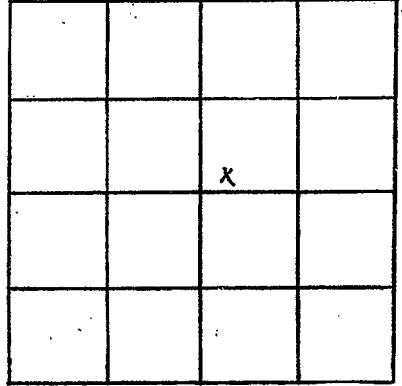

SECTION 25

Please indicate well location X.

ADDITIONAL INFORMATION

If more than one screen,
show locations of each on sketch.