

PEARL RIVER  
 V 2023  
 3-68

MISSISSIPPI  
 BOARD OF WATER COMMISSIONERS  
 416 North State Street  
 Jackson, Mississippi 39201

WATER WELL DRILLERS LOG

March 13 1968 Neil Lumpkin Well Pearl River  
 date well completed firm name county well located  
 Drilling Service

LANDOWNER: ERNEST LINGLE

description of formations encountered	depth	
	from	to
Surface clay	0	20
v sand	20	60
Blue clay	60	150
Good sand	150	174

PICAYUNE PARK  
 PICAYUNE, MISS.  
 (mailing address)


WELL LOCATION:  
 sec. 34 T 5 S R 16 W  
 5 miles NEAST of Picayune  
 (distance) (direction) (nearest town)

WELL PURPOSE: home  
 (home, irrigation, municipal, industrial)

WELL COMPLETION DATA:


- diameter (inches) 2"
- total depth (feet) 174
- static water level (feet) 40 below top of ground.
- casing galv. 168'  
 (material) (depth)  
 2" if telescope see back.  
 (size)
- screen 5'  
 (length) (depth to top)  
 2" St. Steel  
 (size) (material)
- pump 1/2 HP 400 per hr.  
 (type power) (yield gpm)  
 electric
- electric log no  
 (yes or no)  
 (organization running log)
- how well bottom plugged Johnson  
 Back pressure valve

DRILLERS REMARKS:

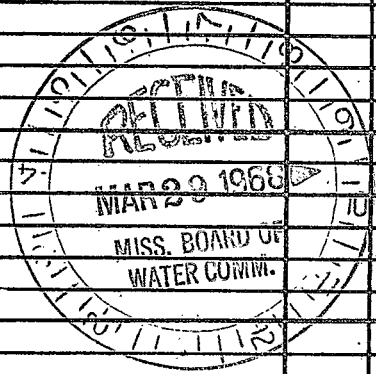

If well telescopes please sketch and show depths.

GROUND LEVEL

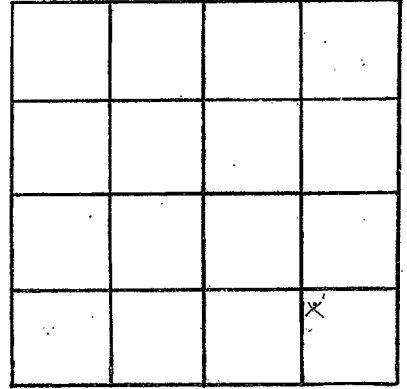

SECTION 34

Please indicate well location X.

ADDITIONAL INFORMATION

If more than one screen, show locations of each on sketch.