

PEARL RIVER  
 V 2025  
 4-68

MISSISSIPPI  
 BOARD OF WATER COMMISSIONERS  
 416 North State Street  
 Jackson, Mississippi 39201

WATER WELL DRILLERS LOG

4-23 1968 Pantow Well Serv Pearl River  
 date well completed firm name county well located

LANDOWNER: Glennis Penton

Rt 2 Box 232

Carriere Miss  
 (mailing address)

WELL LOCATION:

sec. 13 T. 5 S R. 16 W  
 1 1/2 miles North of Caesar  
 (distance) (direction) (nearest town)

WELL PURPOSE: Home  
 (home, irrigation, municipal, industrial)

WELL COMPLETION DATA:


- (1) diameter (inches) 2"
- (2) total depth (feet) 213
- (3) static water level (feet) 102 below top of ground.
- (4) casing Galv. Steel 208' (material) (depth)  
 2" (size) if telescope see back.
- (5) screen 5' 208' (length) (depth to top)  
 2" S. Steel (size) (material)
- (6) pump 1 4 1/2 (HP) (yield gpm)  
 Elec (type power)
- (7) electric log No (yes or no)  
 (organization running log)
- (8) how well bottom plugged Bw Valve

description of formations encountered

from to


Red Clay	0	34
" Sand	34	110
Blue Clay	110	180
Grey sand	180	213

DRILLERS REMARKS:

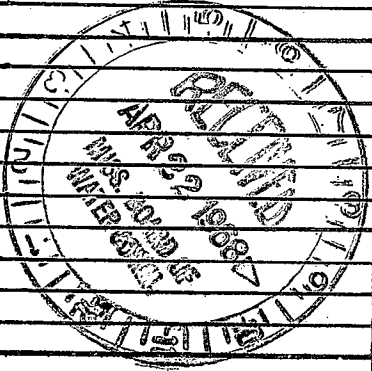

If well telescopes please sketch and show depths.

GROUND LEVEL

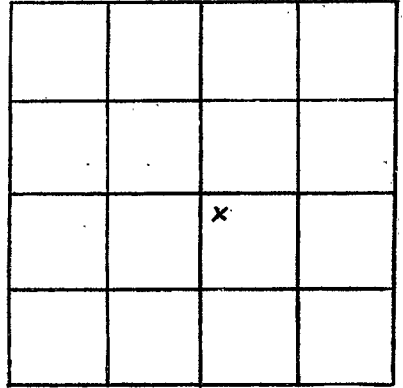

SECTION 13

Please indicate well location X.

ADDITIONAL INFORMATION

If more than one screen,  
show location's of each on sketch.