

Pearl River  
 V 2028  
 7-68

MISSISSIPPI  
 BOARD OF WATER COMMISSIONERS  
 416 North State Street  
 Jackson, Mississippi 39201

WATER WELL DRILLERS LOG

7-9 1968 NEIL LUMPKIN WELL DRILLING SERVICE Pearl River  
 P. O. BOX 117  
 date well completed (STATE) MISS. county well located


LANDOWNER:	description of formations encountered	from	to
<u>George W. Staggs</u>	<u>Surface Clay</u>	<u>0</u>	<u>20</u>
<u>615 Cayton St., Picayune</u> (mailing address)	<u>Surface sand -</u> <u>sand no good</u>	<u>20</u>	<u>30</u>
WELL LOCATION: sec. <u>8</u> T. <u>5</u> S. R. <u>16</u> W.	<u>Blue Clay</u>	<u>30</u>	<u>325</u>
<u>6</u> miles <u>EAST</u> of <u>Carrier</u>	<u>Good sand</u>	<u>325</u>	<u>355</u>
(distance) (direction) (nearest town)			

WELL PURPOSE: Home  
 (home, irrigation, municipal, industrial)

- WELL COMPLETION DATA:
- (1) diameter (inches) 2"
  - (2) total depth (feet) 355
  - (3) static water level (feet) 73 below top of ground.
  - (4) casing galv. 350  
(material) (depth)  
2" if telescope see back.  
(size)
  - (5) screen 5' (length) (depth to top)  
2" St. Steel  
(size) (material)
  - (6) pump 1 450 per hr.  
(HP) (yield gpm)  
electric  
(type power)
  - (7) electric log No  
(yes or no)  
(organization running log)


(8) how well bottom plugged Johnson  
Back Pressure Valve

DRILLERS REMARKS:

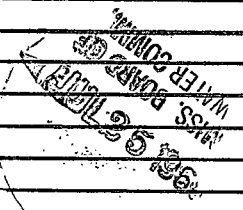

If well telescopes please sketch and show depths.

GROUND LEVEL

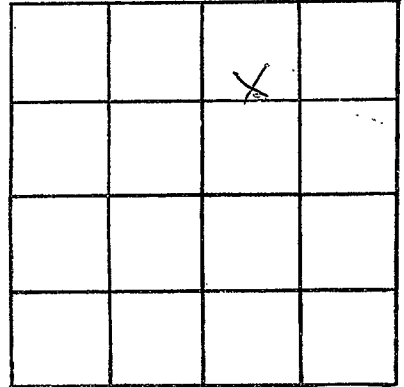

SECTION 8

Please indicate well location X.

ADDITIONAL INFORMATION

If more than one screen,  
show locations of each on sketch.