

Pearl River
V 2030
68

MISSISSIPPI
 BOARD OF WATER COMMISSIONERS
 416 North State Street
 Jackson, Mississippi 39201

WATER WELL DRILLERS LOG

1968 Pontoon Well Serv Pearl River
 date well completed firm name county well located


LANDOWNER: Cecil Stewart
Rt. 3 Box 172
Picayune Miss
 (mailing address)

WELL LOCATION:
 sec. 25 5 S R. 16 W
0 miles W of Caesar
 (distance) (direction) (nearest town)

WELL PURPOSE: Home
 (home, irrigation, municipal, industrial)

- WELL COMPLETION DATA:
- (1) diameter (inches) 2"
 - (2) total depth (feet) 446'
 - (3) static water level (feet) 78 below
 top of ground.
 - (4) casing Orls, 439'
 (material) (depth)
2"
 (size) if telescope see back.
 - (5) screen 5' 439'
 (length) (depth to top)
2" S. Steel
 (size) (material)
 - (6) pump 1 6
 (HP) (yield gpm)
Elec
 (type power)
 - (7) electric log NO
 (yes or no)
 (organization running log)
 - (8) how well bottom plugged Bu. Valve


description of formations encountered	From	To
Clay	0	18
sand	18	65
White Clay	65	75
Blue Clay	75	310
Fine sand	310	357
Blue Clay	357	400
Grey sand	400	446

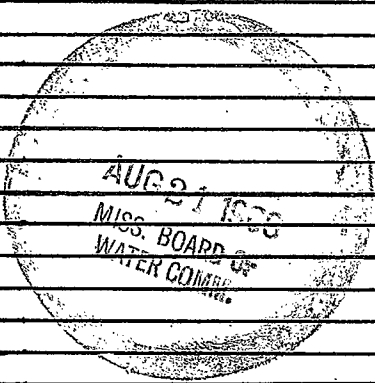

DRILLERS REMARKS:

If well telescopes please sketch and show depths.

GROUND LEVEL

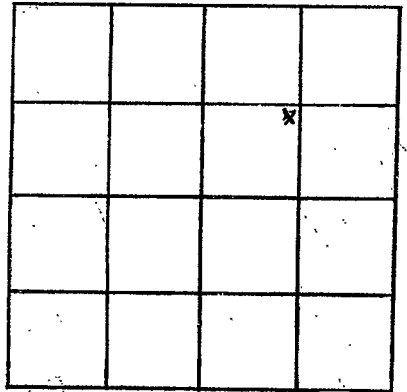

SECTION 25

Please indicate well location X.

ADDITIONAL INFORMATION

If more than one screen,
show locations of each on sketch.